

CERTIFIED RECORD OF LAND CORNER MONUMENTATION


E-25

History of original corner establishment:

Corner established by Eugene P. McCornack under GLO contract no. 398 dated July 2, 1881.

Surveyor General records state:

Set post 4 ft long 4 ins square 24 ins in the ground for cor to secs 1, 6, 7 and 12 marked T 9 S 6 on NE, R 37 E S 7 on SE, R 36 S 12 on SW and S 1 on NW faces with 1 notch on N and 5 notches on S edges from which:

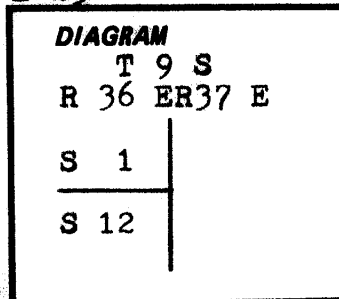

A tamarack 20 ins diam bears S 45° E, 20 lks dist marked T 9 S R 37 E S 7 BT
A fir 10 ins diam bears S 50° W, 25 lks dist marked T 9 S R 36 E S 12 BT
All other trees within limits dead, raised a mound of stone alongside.

Description of corner evidence found:

A fir 16 ins diam for section 12 bearing tree with healed blaze.

A tamarack, 25 ins diam bears S 45° E, 13.2 feet for other bearing tree.

Description of monument and accessories | established to perpetuate the original location of this corner:

At position established by distance intersection from the above described original accessories, set a 2½ inch aluminum cap on a 2 inch aluminum pipe 31 inches long and projecting 5 inches out of the ground with a surrounding rock mound. Placed a 6 foot steel fence post alongside with a sign 54-9 attached.

Aluminum cap marked thus:

	T 9 S	
R 36 E		R 37 E
S 1		
S 12		
1984		
ORLS 1639		

New bearing trees:

A fir 9 ins diam bears N 18° W, 32.7 ft dist marked T 9 S R 36 E S 1 BT

A fir 15 ins diam bears N 80° E, 22.0 ft dist marked X BT
Each new bearing tree has a brass washer marked PLS 1639 nailed flush with BT blaze.

Each bearing tree has a sign 54-3 and sign 54-9 attached below a 6 inch band of red paint painted around.

I hereby certify that the above described corner monument was properly established under my supervision on Sept. 27, 1984, and witnessed by Jim DeMastus and Daryl Schuchardt.

Office of.....Surveyor..... County of.....Baker
State of.....Oregon..... I hereby certify that the within instrument was filed in this office
for record on the.....11 day of.....June....., 1985
..... by
(COUNTY OFFICIAL) (DEPUTY)

