


CERTIFIED RECORD OF LAND CORNER MONUMENTATION

J-25

History of original corner establishment:

Corner established by Eugene P. McCornack under GLO contract no. 398 dated July 2, 1881.

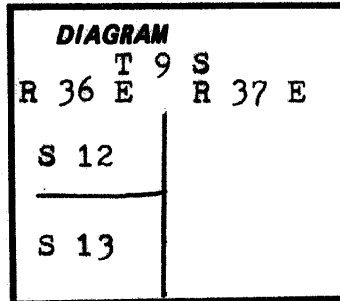

Surveyor General records state:

Set post 4 ft long 4 ins square 24 inches in the ground for cor to sees 7, 12, 13 and 18 marked T 9 S S 7 on NE, R 37 E S 18 on SE, R 36 E S 13 on SW, and S 12 on NW faces with 2 notches on N and 4 notches on S edges from which:

A fir 10 ins diam bears N 15° E, 20 lks dist marked T 9 S R 37 E S 7 BT
A fir 14 ins diam bears S 5° E, 28 lks dist marked T 9 S R 37 E S 18 BT
A pine 40 ins diam bears S 30° W, 25 lks dist marked T 9 S R 36 E S 13 BT
A fir 6 ins diam bears N 30° W, 15 lks dist marked T 9 S R 36 E S 12 BT

Description of corner evidence found:

The ~~east~~ southeast BT is a fir 38 ins diam with healed blaze.
The southwest BT is a fir 38 ins diam with full scribes visible.
The northwest BT is a down rotten tree with fragmentary scribes.
The northeast BT is a dead fir 26 ins diam and healed blaze.

Description of monument and accessories | established to perpetuate the original location of this corner:

At position established as locus of distance intersections from the above described accessories set a 2 1/4 inch aluminum cap on a 2 inch aluminum pipe 31 inches long and projecting 6 inches out of the ground with a surrounding rock mound. Placed a 6 foot steel fence post alongside with a sign 54-9 attached.

Aluminum cap marked thus:

T 9 S
R 36 E R 37 E
S 12
S 23

1984
ORLS 1639

New bearing trees:

A fir 7 ins diam bears N 16° E, 67.0 ft dist marked X BT
A fir 10 ins diam bears N 26° W, 137.4 ft dist marked T 9 S R 36 E S 12 BT

Each of these bearing trees has a brass washer marked PLS 1639 nailed flush with BT blaze and all accessories have a sign 54-3 and sign 54-9 attached below a red band of paint around.

I hereby certify that the above described corner monument was properly established under my supervision on Sept. 27, 1984, and witnessed by Jim DeMastus and Daryl Schuchardt.

Office of..... County of.....
State of Oregon, I hereby certify that the within instrument was filed in this office for record on the June day of 1985
..... by
(COUNTY OFFICIAL) (DEPUTY)

