


CERTIFIED RECORD OF LAND CORNER MONUMENTATION

History of original corner establishment:

The corner was originally established by Arthur Philbrick under Mineral Survey No. 477, during June and July 1902. The original notes state that at the corner a scribed tamarack post 4' long by 4" sq. was set 12" in the ground from which:

- A 16" tamarack bears $N40^{\circ}55'W-20.89'$.
- A 6" red fir bears $S84^{\circ}35'E-37.02'$.
- Both marked B.T.B.Mt. 1-477.

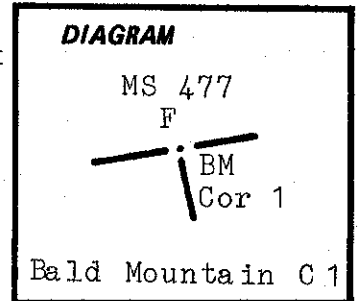

Description of corner evidence found:

Found remains of the original post lying on the original earth mound. Also, found remains of the post underground from which:

- A 23" western larch bears $N41^{\circ}W-21.5'$ with healed blaze (original bearing tree).

Description of monument and accessories I established to perpetuate the original location of this corner:

Set a $2\frac{1}{2}"$ by 30" aluminum pipe with a $2\frac{1}{2}"$ aluminum cap 24" in the ground and surrounded with a mound of earth and stone. Placed remains of original post on the mound. From the monument:

- A 6" white fir bears $N48^{\circ}E-7.3'$ scribed 1-BM-477 BT.
- New bearing tree has a brass washer stamped PLS 1106 nailed to the face of blaze.
- Attached sign 54-3 and 54-9 to each bearing tree and painted the face of blaze and a 6" red band around each bearing tree.
- Set steel fence posts on National Forest Boundary SE and SW of corner and attached sign 54-9 to one post and sign 54-2 to both posts.

Used steel tape and staff compass with $20^{\circ}E$ declination, measured to the center of the bearing trees.

This corner was remonumented on July 24, 1985.

Witness: John Tuttle

Cap is marked:

MS 477



1985
PLS 1106

REGISTERED
PROFESSIONAL
LAND SURVEYOR

William R. Wells

OREGON
JULY 22, 1977
WILLIAM R. WELLS
1106

Office of.....County...Surveyor..... County of.....Baker
State of.....Oregon....., I hereby certify that the within instrument was filed in this office
for record on the...27... day of.....Aug....., 1985

..... by
(COUNTY OFFICIAL) (DEPUTY)

Form R6-7100-57 (9/71)

☆U.S. GOVERNMENT PRINTING OFFICE-1983-793-276

FILED.....
BAKER COUNTY SURVEYOR
SURVEY NO. 9-36-32