


CERTIFIED RECORD OF LAND CORNER MONUMENTATION

History of original corner establishment:

The corner was originally established by Arthur Philbrick under Mineral Survey No. 477, during June and July 1902. The original notes state that at the corner a scribed tamarack post 4' long by 4" sq. was set 12" in the ground and surrounded by a mound of earth from which:

A 16" red fir bears N50°40'E-10'.
An 8" black pine bears S30°36'W-71.86'.
Both marked B.T.F. 1-E.F. 1-477.

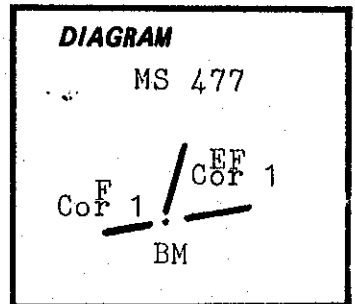

Fairview Cor 1
East Fairview Cor 1

Description of corner evidence found:

Found original post in the mound of earth at ground level from which:

A 28" white fir stump bears N54°W-34.7' with fragmentary scribing (original bearing tree).
A 10" dead, standing, lodgepole pine bears S31°W-72.2' with scribing visible on open blaze (original bearing tree).

Found remains of rotted post lying beside mound.

Description of monument and accessories I established to perpetuate the

original location of this corner:

Set a 2½" by 30" aluminum pipe with a 2½" aluminum cap 24" in the ground and surrounded with a mound of earth and a few stones. Placed remains of original post on the mound. From the monument:

An 11" alpine fir bears S59½°E-25.2' scribed 1-F-1-EF-477 BT.
An 8" white fir bears N39½°W-17.9' scribed 1-F-1-EF-477 BT.
New bearing trees have a brass washer stamped PLS 1106 nailed to the face of blaze. Attached signs 54-9 and 54-3 to each bearing tree and painted face of blaze and a 6" red band around each bearing tree. Set steel fence post on claim line near corner and attached sign 54-9.

Used steel tape and staff compass with 20°E declination, measured to the center of the bearing trees.


This corner was remonumented on July 26, 1985.

Witness: John Tuttle


Cap is marked:

MS 477
EF
Cor 1
BM

1985
PLS 1106

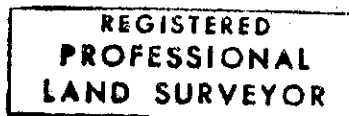

William R. Wells

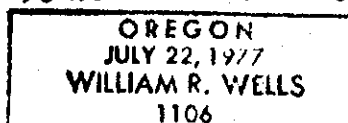

Office of.....County.....Surveyor..... County of.....Baker.....
State of.....Oregon....., I hereby certify that the within instrument was filed in this office
for record on the...27... day of.....Aug....., 1985
..... by
(COUNTY OFFICIAL) (DEPUTY)