


CERTIFIED RECORD OF LAND CORNER MONUMENTATION

History of original corner establishment:

The corner was originally established by Arthur Philbrick under Mineral Survey No. 477, during June and July 1902. The original notes state that at the corner a scribed black pine post 4' long by 4" sq. was set 12" in the ground from which:
A 12" red fir bears S20°52'W-65.66'.
A 6" red fir bears S69°40'E-49.86'.
Both marked B.T.E.F.S.C.-477.

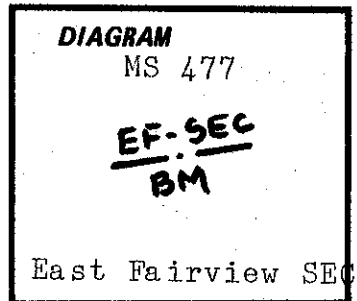

Description of corner evidence found:

Found the rotted remains of the post at ground level and the rotten remains of the post lying beside the post hole. From the corner:

A 26" white fir stump bears S69°E-50.3' with catface (original bearing tree).
A 28" white fir stump bears S21½°W-66.5' with catface (original bearing tree).

Description of monument and accessories established to perpetuate the original location of this corner:

Set a 2½" by 30" aluminum pipe with a 2½" aluminum cap 24" in the ground and surrounded with a mound of earth and stone. Placed remains of the original post on the mound. From the monument:

A 6" western larch bears S74°E-6.6' scribed SEC-EF-477 BT.
An 8" lodgepole pine bears S82°W-28.0' scribed SEC-EF-477 BT.
New bearing trees have a brass washer stamped PLS 1106 nailed to the face of blaze. Attached signs 54-9 and 54-3 to each bearing tree and painted the face of blaze and a 6" red band around each bearing tree. Set steel fence post on claim line and attached sign 54-9.

Used steel tape and staff compass with 20°E declination, measured to the center of the bearing trees.

This corner was remonumented on July 26, 1985.

Witness: John Tuttle

Cap is marked:


MS 477

EF-SEC
BM

1985
PLS 1106



William R. Wells

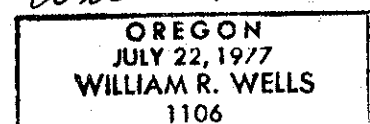

Office of.....County Surveyor.....County of.....Baker.....
State of.....Oregon.....I hereby certify that the within instrument was filed in this office
for record on the...27... day of.....Aug....., 1985
..... by
(COUNTY OFFICIAL) (DEPUTY)

FILED.....


SURVEY NO. 9-36-35

8-36-