


CERTIFIED RECORD OF LAND CORNER MONUMENTATION

History of original corner establishment:

The corner was originally established by Arthur Philbrick under Mineral Survey No. 477, during June and July 1902. The original notes state that at the corner a scribed tamarack 4' long by 4" sq. was set 12" in the ground and surround with a mound of earth from which:
An 8" tamarack bears N81°42'W-35.4' scribed B.T.K.N.C.-477.

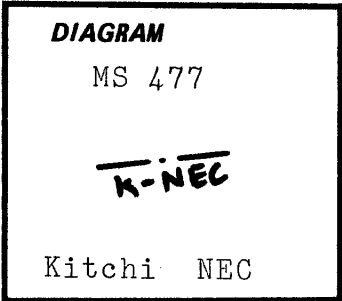

Description of corner evidence found:

Found a mound of stone and the remains of the original post at ground level from which:

A 17" western larch stump bears N81°W-35.6' with catface (original bearing tree).

Description of monument and accessories | established to perpetuate the original location of this corner:

Set a 2½" by 30" aluminum pipe with a 2½" aluminum cap 24" in the ground and surrounded with a mound of earth and stone, from which:

A 12" alpine fir bears N42½°W-26.6' scribed NEC-K-477 BT.
A 7" Engleman spruce bears N7½°W-22.3' scribed NEC-K-477 BT.
New bearing trees have a brass washer stamped PLS 1106 nailed to the face of blaze. Attached sign 54-3 and 54-9 to each bearing tree and painted face of blaze and a 6" red band around each bearing tree. Set steel fence posts on National Forest Boundary NE and SW of corner and attached sign 54-9 to one post and sign 54-2 to both posts.

Used steel tape and staff compass with 20°E declination, measured to the center of the bearing trees.

This corner was remonumented on July 25, 1985.

Witness: John Tuttle

Cap is marked:
MS 477

K-NEC
1985
PLS 1106

REGISTERED
PROFESSIONAL
LAND SURVEYOR

William R. Wells

OREGON
JULY 22, 1977
WILLIAM R. WELLS
1106

Office of..... County Surveyor..... County of..... Baker.....
State of..... Oregon....., I hereby certify that the within instrument was filed in this office
for record on the...27... day of..... Aug....., 1985
..... by
(COUNTY OFFICIAL) (DEPUTY)

FILED.....
BAKER COUNTY SURVEYOR
SURVEY NO. 9-36-39
8-36-