


CERTIFIED RECORD OF LAND CORNER MONUMENTATION

History of original corner establishment:

The corner was originally established by Arthur Philbrick under Mineral Survey No. 477, during the survey of June and July 1902. The original notes state that at the corner a scribed black pine post 4' long by 4" sq. was set in the ground and surrounded with a mound of earth and stone from which:

A 24" tamarack bears N67°36'W-15.36'.
A 26" yellow pine bears S61°25'W-38.16'.
Both marked B.T.A.W.C.-477.

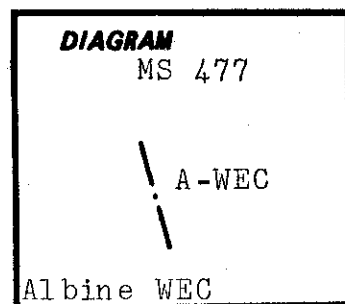

Description of corner evidence found:

Found a mound of stone and the remains of the rotted post at ground level from which:

A 30" ponderosa pine bears S62½°W-39.2' with healed blaze (original bearing tree).
A 26" western larch stump bears N62½°W-16.2' with partial open blaze (original bearing tree).

Description of monument and accessories established to perpetuate the original location of this corner:

A 2½" by 30" aluminum pipe with a 2½" aluminum cap 22" in the ground surrounded with a mound of earth and stone from which:

A 4" white fir bears N82½°W-20.6' scribed WEC-A-477 BT.
A bearing tree has a brass washer stamped PLS 1106 nailed to the face of blaze.
Attached signs 54-3 and 54-9 to each bearing tree and painted face of blaze and
A red band around each bearing tree. Set steel fence posts on National
Forest Boundary NW and SE of corner and attached sign 54-9 to one post and
sign 54-2 to both posts.

Cap is marked:

A steel tape and staff compass with 20°E
inclination, measured to the center of the
bearing trees.

MS 477

A-WEC

1985

PLS 1106

This corner was remonumented on August 14, 1985.

Witness: John Tuttle

REGISTERED
PROFESSIONAL
LAND SURVEYOR

William R. Wells

OREGON
JULY 22, 1977
WILLIAM R. WELLS
1106

Office of.....County..Surveyor..... County of.....Baker.....
State of.....Oregon....., I hereby certify that the within instrument was filed in this office
for record on the...8... day of.....Oct....., 1985

..... by
(COUNTY OFFICIAL) (DEPUTY)