


CERTIFIED RECORD OF LAND CORNER MONUMENTATION

History of original corner establishment:

This corner was originally established by Arthur Philbrick under Mineral Survey No. 477, during June and July 1902. The original notes state that at the corner a scribed tamarack post 4' long by 6" sq. was set 12" in the ground and surrounded with a mound of rocks from which: Discovery point bears S80°25'W-737.5'.

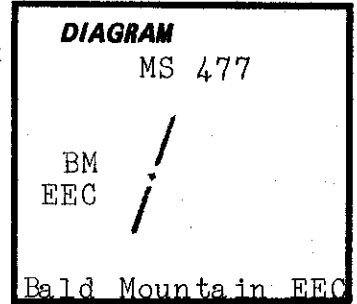

Description of corner evidence found:

Found a mound of earth and stone with the rotted remains of the post in hole in the mound.

Description of monument and accessories | established to perpetuate the original location of this corner:

Set a 2½" by 30" aluminum pipe with a 2½" aluminum cap 20" in the ground and surrounded with a mound of earth and stone from which:

An 11" white fir bears S87½°E-17.8' scribed EEC-BM-477 BT.

A 12" western larch bears N4½°E-40.2' scribed EEC-BM-477 BT.

Two bearing trees have a brass washer stamped PLS 1106 nailed to face of blaze. Attached sign 54-3 and 54-9 to each bearing tree and painted face of blaze and a 6" red band around each bearing tree. Set steel fence posts on National Forest Boundary SE and NW of corner and attached sign 54-9 to one post and sign 54-2 to both posts.

Used steel tape and staff compass with 20°E declination, measured to the center of the bearing trees.

This corner was remonumented on August 28, 1985.

Witness: John Tuttle

Cap is marked:
MS 477

BM
EEC

1985
PLS 1106

REGISTERED
PROFESSIONAL
LAND SURVEYOR

William R. Wells

OREGON
JULY 22, 1977
WILLIAM R. WELLS
1106

Office of.....County Surveyor.....County of.....Baker
State of.....Oregon.....I hereby certify that the within instrument was filed in this office
for record on the...8...day of.....Oct....., 1985

.....by
(COUNTY OFFICIAL)

(DEPUTY)