


CERTIFIED RECORD OF LAND CORNER MONUMENTATION

History of original corner establishment:

The corner was originally established by Arthur Philbrick under Mineral Survey No. 477, during the survey of June and July 1902. The original notes state that at the corner a slate stone, 24" by 18" by 15", was chiseled and set 12" in the ground and surrounded with a mound of stone from which:

- A 15" tamarack bears S21°13'E-35.38'.
- A 20" pine bears S72°06'E-46.77'.
- Both marked B.T.S.4-A.2-477.

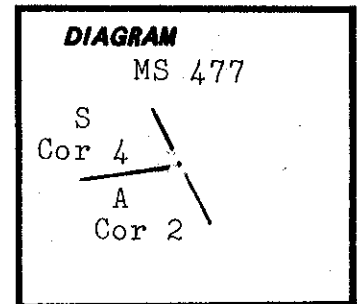

Saginaw Cor. 4
Albine Cor. 2

Description of corner evidence found:

Found a 29" ponderosa pine bearing S21½°E-35.4' to face of blaze and 36.0' to centerline with opened blaze and visible scribing (original notes call this tree a tamarack).
Re-established corner position by measuring record bearing and distance from face of blaze.

Description of monument and accessories established to perpetuate the original location of this corner:

Set a 2½" by 30" aluminum pipe with a 2½" aluminum cap 28" in the ground and surrounded with a mound of earth and stone from which:


An 18" douglas fir bears N56½°W-19.3' scribed 4-S-2-A-477 BT.
New bearing tree has a brass washer stamped PLS 1106 nailed to face of blaze. Attached sign 54-3 and sign 54-9 to each bearing tree and painted face of blaze and a 6" red band around each bearing tree. Set steel fence posts on National Forest Boundary NW and SE of corner and attached sign 54-2 to both posts and sign 54-9 to one post.

Used steel tape and staff compass with 20°E declination, measured to the center of the bearing trees.

This corner was remonumented on August 30, 1985.

Witness: John Tuttle

Cap is marked:
MS 477

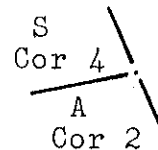

1985
PLS 1106

REGISTERED
PROFESSIONAL
LAND SURVEYOR

William R. Wells

OREGON
JULY 22, 1977
WILLIAM R. WELLS
1106

Office of.....County Surveyor.....County of.....Baker.....
State of.....Oregon....., I hereby certify that the within instrument was filed in this office
for record on the...8... day of.....Oct....., 1985

..... by
(COUNTY OFFICIAL)

(DEPUTY)