


CERTIFIED RECORD OF LAND CORNER MONUMENTATION

History of original corner establishment:

This corner was not "originally established".

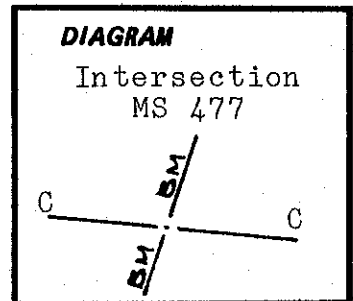

Bald Mountain -
Cheboygan

Description of corner evidence found:

This corner was not "originally established".

Description of monument and accessories | established to perpetuate the
original location of this corner:

Set a 2½" by 30" aluminum pipe with a 2½" aluminum cap 22" in the ground
and surrounded with a mound of earth and stone from which:

A 12" engleman spruce bears S89°E-41.2' scribed Intex-BM-C-477 BT.
A 13" engleman spruce bears S40½°E-35.9' scribed Intex-BM-C-477 BT.
New bearing trees have a brass washer stamped PLS 1106 nailed to face of blaze.
Attached sign 54-3 and 54-9 to each bearing tree and painted face of blaze
and a 6" red band around each bearing tree. Set steel fence posts on National
Forest Boundary SE of corner and attached sign 54-9 to one post and sign 54-2 to
both posts.

Used steel tape and staff compass with 20°E
declination, measured to the center of the
bearing trees.

This corner was remonumented on August 30, 1985.

Witness: John Tuttle

REGISTERED
PROFESSIONAL
LAND SURVEYOR

William R. Wells

OREGON
JULY 22, 1977
WILLIAM R. WELLS
1106

Cap is marked:

Intersection
MS 477

1985
PLS 1106

Office of.....County...Surveyor..... County of...Baker
State of.....Oregon....., I hereby certify that the within instrument was filed in this office
for record on the...2... day of.....Oct....., 1985

..... by
(COUNTY OFFICIAL) (DEPUTY)

Form R6-7100-57 (9/71)

☆U.S. GOVERNMENT PRINTING OFFICE - 1983-793-276

FILED.....

BAKER COUNTY SURVEYOR

SURVEY NO. 9-36-60

8-36-