


CERTIFIED RECORD OF LAND CORNER MONUMENTATION

History of original corner establishment:

The corner was originally established by Arthur Philbrick under Mineral Survey No. 477, during June and July 1902. The original notes state that at the corner a scribed tamarack post 4' long by 4" sq. was set 12" in the ground and surrounded with a mound of earth from which:

A 16" tamarack bears S55°56'W-24.81'.
A 10" tamarack bears N3°10'W-25.15'.
Both marked B.T.K.4-C.3-477.

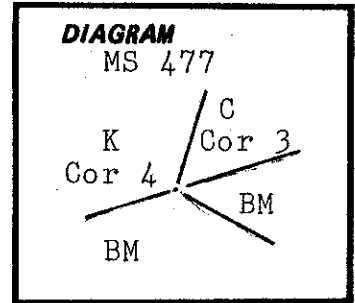

Kitchi Cor. 4
Cheboygan Cor. 3

Description of corner evidence found:

A 14" western larch stump bears N2°W-25.2' to face blaze and 25.6' to center line with catface. (original bearing tree).
A 24" western larch stump bears S57°W-24.8' to face blaze and 25.4' to center line with catface. (original bearing tree).

Re-established corner position using record distances from face of blaze on found bearing tree stumps. The area has been skidded over.

Description of monument and accessories I established to perpetuate the original location of this corner:


Set a 2½" by 30" aluminum pipe with a 2½" aluminum cap 22" in the ground and surrounded with a mound of earth and stone. From the monument:

An 18" white fir bears S39½°W-31.5' scribed 4-K-3-C-477 BT.
A 20" engelman spruce bears S86½°W-38.5' scribed 4-K-3-C-477 BT.
New bearing trees have a brass washer stamped PLS 1106 nailed to face of blaze. Attached signs 54-3 and 54-9 to each bearing tree and painted face of blaze and a 6" red band around each bearing tree. Set steel fence post on claim line near corner and attached sign 54-9.

Used steel tape and staff compass with 20°E declination, measured to the center of the bearing trees.

This corner was remonumented on August 28, 1985.

Witness: John Tuttle

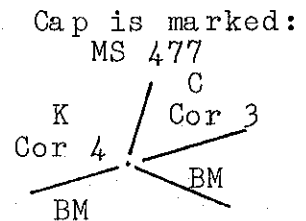

1985
PLS 1106

REGISTERED
PROFESSIONAL
LAND SURVEYOR

William R. Wells

OREGON
JULY 22, 1977
WILLIAM R. WELLS
1106

Office of.....County Surveyor.....County of.....Baker.....
State of.....Oregon....., I hereby certify that the within instrument was filed in this office
for record on the...8... day of.....Oct....., 1985
..... by
(COUNTY OFFICIAL) (DEPUTY)