


CERTIFIED RECORD OF LAND CORNER MONUMENTATION

History of original corner establishment:

This corner was originally established by Arthur Philbrick under Mineral Survey No. 477, during June and July 1902. The original notes state that at the corner a scribed black pine post 4' long by 4" sq. was set 12" in the ground and surrounded with a mound of earth.

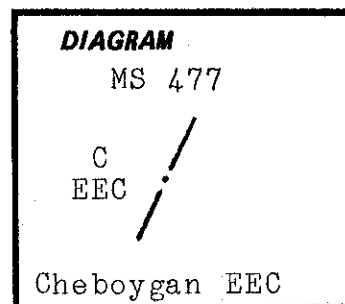

Description of corner evidence found:

Found the rotted remains of the original post lying beside an earth mound. Also, found the remains of the original post below ground.

Description of monument and accessories I established to perpetuate the original location of this corner:

Set a 2½" by 30" aluminum pipe with a 2½" aluminum cap 26" in the ground and surrounded with a mound of earth and stone from which:

A 10" white fir bears N83½°E-42.3' scribed EEC-C-477 BT.

A 6" white fir bears S14½°W-11.0' scribed EEC-C-477 BT.

Two bearing trees have a brass washer stamped PLS 1106 nailed to face of blaze. Attached signs 54-3 and 54-9 to each bearing tree and painted face of blaze and a 6" red band around each bearing tree. Set steel fence posts on National Forest Boundary NE and SW of corner and attached sign 54-9 to one post and sign 54-2 to both posts.

Used steel tape and staff compass with 20°E declination, measured to the center of the bearing trees.

This corner was remonumented on August 28, 1985.

Witness: John Tuttle

Placed remains of the original wood post on the new mound.

Cap is marked:

MS 477

C
EEC

1985
PLS 1106

REGISTERED
PROFESSIONAL
LAND SURVEYOR

William R. Wells

OREGON
JULY 22, 1977
WILLIAM R. WELLS
1106

Office of...County Surveyor..... County of...Baker.....
State of...Oregon....., I hereby certify that the within instrument was filed in this office
for record on the...8... day of...Oct....., 1985

..... by
(COUNTY OFFICIAL) (DEPUTY)