


CERTIFIED RECORD OF LAND CORNER MONUMENTATION

History of original corner establishment:

The corner was originally established by Arthur Philbrick under Mineral Survey No. 477, during June and July 1902. The original notes state that at the corner a black pine post 4' long and 4" sq. was set 12" in the ground and surrounded with a mound of earth from which:
A 12" black pine bears S60°08'W-8.95'.
An 8" black pine bears S75°33'E-20.45'.
Both marked B.T.F.3-W.6-477.

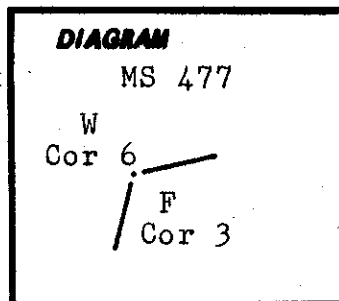

Fairview Cor. 3
Whitehall Cor. 6

Description of corner evidence found:

A 13" lodgepole pine bears S75½°E-20.5' with visible scribing on partly healed blaze (original bearing tree).
A root hole bears S60°W-9'.

Re-established corner by record bearing and distance measurement from standing bearing tree, measuring from face of blaze.

Description of monument and accessories established to perpetuate the original location of this corner:

Set a 2½" by 30" aluminum pipe with a 2½" aluminum cap 12" in the ground and surrounded with a mound of earth and stone from which:
A 13" engleman spruce bears N7½°W-15.6' scribed 3-F-6-W-477 BT.

New bearing tree has a brass washer stamped PLS 1106 nailed to the face of blaze. Attached sign 54-3 and 54-9 to each bearing tree and painted face of blaze and a 6" red band around each bearing tree. Set steel fence post on claim line near corner and attached sign 54-9.

Used steel tape and staff compass with 20°E declination, measured to the center of the bearing trees.

This corner was remonumented on August 8, 1985.

Witness: John Tuttle

Cap is marked:
MS 477

W
Cor 6

F
Cor 3

1985
PLS 1106

REGISTERED
PROFESSIONAL
LAND SURVEYOR

William R. Wells

OREGON
JULY 22, 1977
WILLIAM R. WELLS
1106

Office of.....County Surveyor.....County of.....Baker.....
State of.....Oregon.....I hereby certify that the within instrument was filed in this office
for record on the...8... day of.....Oct....., 1985
..... by
(COUNTY OFFICIAL) (DEPUTY)

Form R6-7100-57 (9/71)

★ GPO—708-276

FILED
COUNTY CLERK
SEPT 10 1985
9-36-68
8-36-