

CERTIFIED RECORD OF LAND CORNER MONUMENTATION

Z-23 T 8 S R 36 E


History of original corner establishment:

Corner established by Otis O. Gould under special instructions dated Nov. 27, 1935, which provided for the surveys included under Group No. 179.

Surveyor General records state:

Set an iron post 3 ft long 1 in dia 27 ins in ground for $\frac{1}{4}$ sec cor of sec 36 only with brass cap marked (as shown in corner diagram) from which:

A fir 36 ins dia bears N55°E, 74 lks dist marked $\frac{1}{4}$ S36 BT.
A fir 20 ins dia bears N40°W, 64 lks dist marked $\frac{1}{4}$ S36 BT.

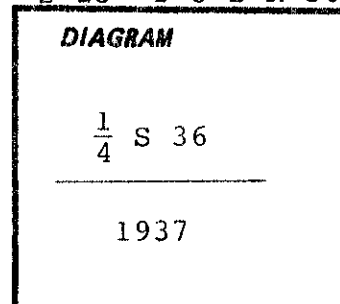

Description of corner evidence found:

Found a 2½" brass cap on 1" iron pipe protruding 3" from mound of stone marked as shown in corner diagram.

A fir 32 ins dia bears N56°E, 48.2 ft with partially healed blaze and visible scribes (record states: N55°E).

A standing dead pine 20 ins dia bears N38°W, 41.1 ft with open blaze and visible scribes (record states: N40°W).

Description of monument and accessories | established to perpetuate the original location of this corner:

Corner monument maintained to USFS standards as follows...cleared brush and debris from around cor monument and made rock mound. Placed 6' steel fence post E of cor with sign 54-9 attached.

New bearing tree established:

A fir 12 ins dia bears N52½°W, 39½ft marked $\frac{1}{4}$ S36 BT.

Each original bearing tree and each new bearing tree has signs 54-3 and 54-9 attached below a 6 inch band of red paint, additionally each new bearing tree has a brass washer marked PLS 1106 nailed flush with BT blaze.

Compass declination 19°East.

I hereby certify that the above corner monument was properly maintained to U.S.F.S. standards under my supervision and witnessed by Willard Hulick on August 2, 1986.

REGISTERED
PROFESSIONAL
LAND SURVEYOR

William R. Wells

OREGON
JULY 22, 1977
WILLIAM R. WELLS
1106

Office of.....County Surveyor.....County of.....Baker.....
State of.....Oregon....., I hereby certify that the within instrument was filed in this office
for record on the.....day of....., 19.....

.....by.....
(COUNTY OFFICIAL) (DEPUTY)