


CERTIFIED RECORD OF LAND CORNER MONUMENTATION

West End Center Corner, Annululu Lode, M.S. 382 A

History of original corner establishment:

Corner ORIGINALLY established by C.M.Foster, U.S. Deputy Mineral Surveyor under instructions dated December 7, 1899, for mineral survey no. 382A & B.

Surveyor General records state: A pine post 4' long 4" square set 18" in ground scribed W Cen end-382-A identical with W Cen end of original location. A fir 8" dia brs S33°E, 20' dist blazed and scribed W Cen end-382-A BT.

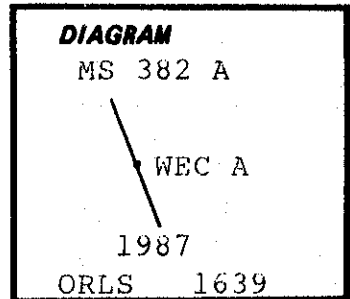


Corner RECOVERED and PERPETUATED by J.R.Mitchell, experienced corner recovery technician, as noted below. No record filed with Baker County Surveyor.

Description of corner evidence found:

No trace of original pine post.

A 2½" brass cap on 1" galvanized iron pipe in rock mound (as shown beside) with 4" x 4" x 24" wood post alongside with fragment scribes, from which:
JRM BT: A white fir 6" dia brs N58°E, 17.4' mkd "AN WEC MS 447 BT on partially healed blaze.

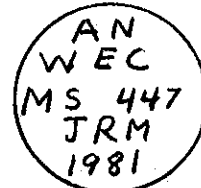

A white fir 6" dia brs S76°E, 10.5' mkd "AN WEC MS 447 BT".
OBT: A sawed fir stump 18" dia brs S33°E, 20' dist per record with lower portion of blaze visible inside 5" overgrowth & 4" from center of tree no visible scribes.

Description of monument and accessories | established to perpetuate the original location of this corner:

At position of JRM brass cap monument which is the best remaining evidence of original corner...


Removed brass cap monument and replaced with 2" x 30" aluminum pipe with 2½" aluminum cap 25" in ground surrounded with rock mound. Cap marked as shown in corner diagram. Set steel fence post with signs 54-2 & 54-9 attached.

Removed the marks from JRM BTs and marked the following new BTs:
A lodgepole pine 8" dia brs S22°W, 70.5' dist mkd A-WEC-382A BT.
A western larch 9" dia brs S60°W, 73.8' dist mkd A-WEC-382A BT.


Each BT has a sign 54-3 & 54-9 attached below a 6" band of red paint, and each new BT has a brass washer marked PLS 1639 nailed flush with BT blaze.

Compass declination 20° East.

I hereby certify that the above corner monument was properly remonumented to U.S.F.S. standards by me and witnessed by Bill Gohring on October 14, 1987.

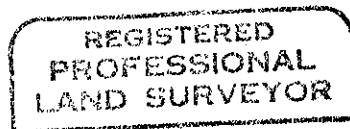

William L. Hanley

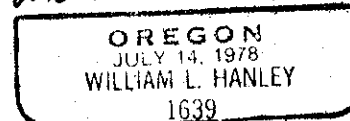

Office of.....County Surveyor.....County of.....Baker
State of.....Oregon....., I hereby certify that the within instrument was filed in this office
for record on the.....day of....., 19.....

.....by.....
(COUNTY OFFICIAL) (DEPUTY)

FILED 2-2-88
BAKER COUNTY SURVEYOR
SURVEY NO. 9-36-91