


CERTIFIED RECORD OF LAND CORNER MONUMENTATION

Corner No.1, Bunker Hill Lode, M.S. 329

History of original corner establishment:

Corner ORIGINALLY established by C.M.Foster U.S. Deputy Surveyor under instructions for MS 329 and dated November 4, 1896.

Surveyor General records state: Identical with Cor No. 1 of the location which corner is a post 4" square 4½' long set 18" in the ground with mound of earth scribed 1-329, whence the 1/4 Sec Corner on North side of Sec 1 in Tp 9 S R 36 E bears N3°40'E, 33.82 chains distant and a Fir tree 22" dia bears S52°W, 70' dist blazed and scribed BT 1-329, a fir 14" dia bears S67½°W, 52' dist blazed and scribed BT 1-329.

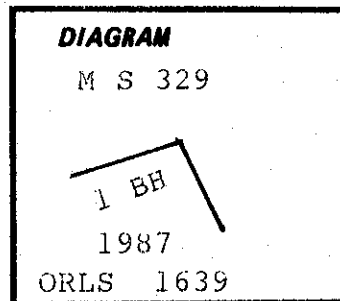

Description of corner evidence found:

Found a rock mound with 4' x 4" x 42" wood post scribed "Cor 1 BH" on one face and "Cor 1 BHL" on another face from which:

A sawed white fir stump 22" diam brs S54°W, 71.2' dist (record, S52°W, 70') with small portion of lower blaze and fragmentary scribe marks inside 2" overgrowth.
A green white fir 27" diam brs S64°W, 53.5' dist (record, S67½°W, 52') with fully healed blaze.

Description of monument and accessories | established to perpetuate the original location of this corner:

At position of original wood post in center of rock mound...

Removed wood post and replaced with 2 " x 30" aluminum pipe with 2½" aluminum cap 25" in ground surrounded with rock mound. Cap marked as shown in corner diagram. Set steel fence post with signs 54-2 & 54-9 attached. Laid post alongside.


New bearing tree established:

A lodgepole pine 7" diam brs S55°E, 17.6' dist mkd BH-1-329 BT.


New bearing trees have a brass washer stamped PLS 1639 nailed to face of blaze. Attached sign 54-3 & 54-9 and painted face of blaze red and 6" band around each BT.

Compass declination 20° East.

I hereby certify that the above corner monument was properly REMONUMENTED to U.S.F.S. standards by me and witnessed by Bill Gohring on October 8, 1987.

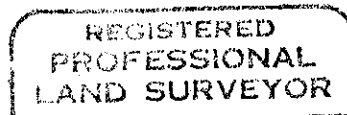

William L. Hanley

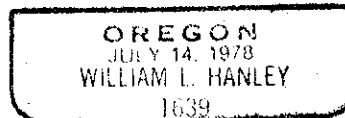

Office of.....County Surveyor..... County of...Baker.....
State of.....Oregon....., I hereby certify that the within instrument was filed in this office
for record on the..... day of....., 19.....
..... by
(COUNTY OFFICIAL) (DEPUTY)