


CERTIFIED RECORD OF LAND CORNER MONUMENTATION

Corner No.1, Lilac Lode, M.S. 376

History of original corner establishment:

Corner ESTABLISHED by John Hagel, U.S. Deputy Mineral Surveyor, under instructions dated September 18, 1899, for the survey of MYRTLE QUARTZ CLAIM, M.S. 375, performed in conjunction with the survey of the LILAC QUARTZ CLAIM, M.S. 376, under instructions dated the same date.

Surveyor General records state: Identical with NW cor of location... Set a fir post 4" square 4½' long 18" in ground with a mound of stones around it, marked it "LILAC Cor 1-376". A white fir tree 12" in diam bears N19°55'W, 25.5 ft. A spruce tree 12" in diam bears N37°05'W, 31.0 ft. Both blazed and marked "LILAC Cor 1-376 BT" Cor No 1 of Myrtle Load Sur 375, brs N13°35'W, 35.5 ft.

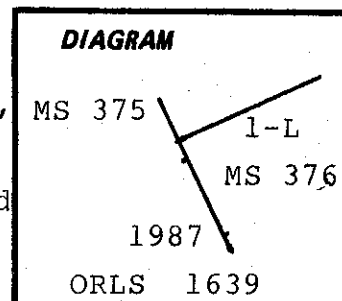

Description of corner evidence found:

Remains of rock mound with rotten wood post in center, from which:

A 30" spurce with partially healed blaze & fragments of scribing brs N37°05'W, 31.0' dist per record.

A 28" white fir with fully healed blaze brs N19°55'W, 25.5' dist per record.

NOTE: These trees were also blazed and marked as the official accessories to the "MYRTLE" corner No 1, M.S. 375.

Description of monument and accessories | established to perpetuate the original location of this corner:

At position of center of rock mound, removed wood post and replaced with...

Set 2 " x 30" aluminum pipe with 2½" aluminum cap 25" in ground with 5" projecting out of the ground surrounded with rock mound. Cap marked as shown in corner diagram. Set steel fence post alongside with signs 54-2 & 54-9 attached.

New bearing trees established:

A lodgepole pine 13" dia brs N47°E, 10.0' dist mkd L-1-376 BT.

New bearing trees have a brass washer stamped PLS 1639 nailed to face of blaze. Attached signs 54-3 & 54-9 and painted face of blaze and 6" band of red paint around each BT.

Compass declination 20° East.

I hereby certify that the above corner monument was properly REMONUMENTED to U.S.F.S. standards by me and witnessed by Bill Gohring on November 17, 1987.

**REGISTERED
PROFESSIONAL
LAND SURVEYOR**

William L. Hanley

**OREGON
JULY 14, 1978
WILLIAM L. HANLEY
1639**

Office of.....County Surveyor.....County of.....Baker.....

State of.....Oregon....., I hereby certify that the within instrument was filed in this office

for record on the..... day of....., 19.....

..... by
(COUNTY OFFICIAL) (DEPUTY)