

CERTIFIED RECORD OF LAND CORNER MONUMENTATION


Corner No.2, Rainbow Lode, also Corner No.5, Boulder Lode, M.S. 447

History of original corner establishment:

Corner originally ESTABLISHED by C.M.Foster, U.S. Deputy Mineral Surveyor under instructions dated Sept. 25, 1901, for mineral survey No 447.

Surveyor General records state:

To cor no 2 Rainbow Lode identical with the NE cor of amended location and also identical with cor no 5 of Boulder Lode of this survey on line 1-2 of the Chapman Lode MS 382...A pine post $4\frac{1}{2}$ ft long, 6 ins square, set 18 ins in the ground surrounded with a mound of earth and stone scribed Rainbow 2-447 and Boulder 5-447.

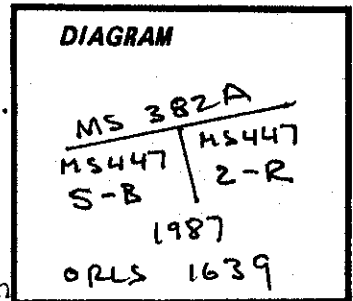

Description of corner evidence found:

Found remains of rotten post to a depth of 18".

Description of monument and accessories | established to perpetuate the original location of this corner:

At position of rotten post remains...


Set 2 " x 30" aluminum pipe with $2\frac{1}{2}$ " aluminum cap 25" in ground with 5" projecting out of ground surrounded with rock mound. Cap marked as shown in corner diagram. Set steel fence post alongside with signs 54-9 attached.

New bearing trees established:


A western larch 11 ins dia. brs. $S04\frac{1}{2}^{\circ}W$, 21.4 ft dist marked R-2-B-5-447BT.
A lodgepole pine 7 ins dia. brs. $S42^{\circ}E$, 31.0 ft dist marked R-2-B-5-447BT.

Each new BT has a brass washer marked PLS 1639 nailed flush to BT blaze and has signs 54-3 and 54-9 attached below a red band of paint. The BT blaze is also painted red.
Compass declination is 20° East.

I hereby certify that the above corner monument was properly REMONUMENTED to U.S.F.S. standards by me and witnessed by Bill Gohring on Dec. 16, 1987.

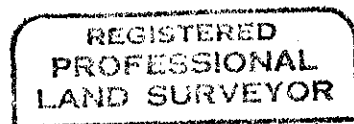

William L Hanley

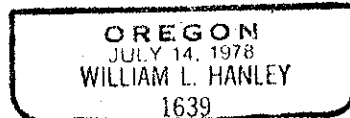

Office of...County Surveyor.....County of.....Baker
State of.....Oregon....., I hereby certify that the within instrument was filed in this office
for record on the..... day of....., 19.....

..... by
(COUNTY OFFICIAL) (DEPUTY)