


CERTIFIED RECORD OF LAND CORNER MONUMENTATION

Corner 1, Annululu Lode, also Corner 1, Chapman Lode, M.S. 382 A, also Corner 4, Boulder Lode, M.S. 447.

History of original corner establishment:

Corner originally ESTABLISHED by C.M. Foster, U.S. Deputy Mineral Surveyor under instructions dated December 7, 1899, for mineral survey No. 382 A & B. Surveyor General records state: Beginning at Cor No 1 Annululu Load. Identical with location corner and also identical with Cor No 1 Chapman Load this survey. A fir post 4 ft long 4 ins square set 18 ins in ground scribed 1-382-A. The quarter section corner on the East line of Sec 1 T9SR36E, W.M. brs S66°58'E, 1092.5 ft dist. A pine 8 ins dia brs N53°W, 18 ft dist blazed 1-382-A-BT. A pine 6 ins dia brs N9°E, 6.5 ft dist blazed 1-382-A-BT. Corner AMENDED by the same C.M. Foster under instructions dated September 25, 1901, for mineral survey No 447. Surveyor General records state: A fir post 4½ ft long 4 ins square set 18 ins in ground surrounded with a mound of earth scribed Boulder 5-447 & Annululu 1-382 & Chapman 1-382. Identical with Cor No 1 of Annululu & Chapman Claims M S 382. Corner RECOVERED and PERPETUATED by J.R. Mitchell, experienced corner recovery technician, as

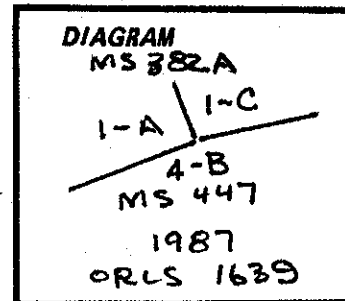

Description of corner evidence found:

A lodgepole pine snag 12" dia with partially healed blaze brs N49°W, 17.5' dist (record, N53°W 18.0') scribed ANNULULU MS 382 Cor 1 BT.
A sawed wind blow snag 9" dia with opened blaze scribed CHAPMAN MS 382 Cor 1 (position of root hole indefinite). These are original BTs.
JRM BTs: A white fir 7" dia brs N5°W, 10.8' dist mkd CH 1 MS 382A BT on partially healed blaze.
A white fir 8" dia brs N61°W, 8.0' dist mkd CH 1 MS 382A BT on partially healed blaze.
A 2½" brass cap on 1" galvanized iron pipe in earth and rock mound marked as shown beside:




Description of monument and accessories I established to perpetuate the original location of this corner:

At position of JRM brass cap monument which is the best available evidence of original corner position...


Removed brass cap monument & replaced with 2" x 30" aluminum pipe with 2½" aluminum cap 20" in ground surrounded with a mound of earth and stone. Set 6' steel fence post alongside with signs 54-2 & 54-9. Corner marked as shown in corner diagram.
Painted 6" band of red around each OBT and JRM-BT.

Compass declination 20° East.

I hereby certify that the above corner monument was properly REMONUMENTED to U.S.F.S. standards by me and witnessed by Bill Gohring on October 14, 1987.

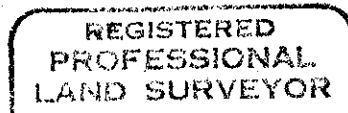

William L. Hanley

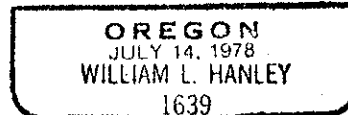

Office of.....County.....Surveyor..... County of..... Baker
State of..... Oregon....., I hereby certify that the within instrument was filed in this office
for record on the..... day of....., 19.....

..... by
(COUNTY OFFICIAL) (DEPUTY)