

LEGEND

- RECOVERED ORIGINAL CORNER POSITION AND REMONUMENTED WITH A 2 1/2-INCH DIAMETER ALUMINUM CAP ON A 2-INCH DIAMETER ALUMINUM PIPE 30 INCHES LONG AS DESCRIBED ON THE ACCOMPANYING CERTIFIED REMONUMENTATION RECORD FILED SEPARATELY.
- FOUND 3/4" x 30 INCH REBAR WITH 1 1/2" DIAM. ALUMINUM CAP ATTACHED AND SET BY L. MYERS, ORLS 699, REMONUMENTED WITH A 2 1/2-INCH DIAM. ALUMINUM CAP ON A 2-INCH DIAM. ALUMINUM PIPE 30 INCHES LONG AS DESCRIBED ON THE ACCOMPANYING CERTIFIED REMONUMENTATION RECORD FILED SEPARATELY.
- FOUND UNRECORDED 2 1/2-INCH DIAM. IRON PIPE 30 INCHES LONG SET BY J. R. MITCHELL, EXPERIENCED CORNER RECOVERY TECHNICIAN, AND REMONUMENTED WITH A 2 1/2-INCH DIAM. ALUMINUM CAP ON A 2-INCH DIAM. ALUMINUM PIPE 30 INCHES LONG AS DESCRIBED ON THE ACCOMPANYING CERTIFIED REMONUMENTATION RECORD FILED SEPARATELY.
- ORIGINAL CORNER POSITION NOT RECOVERED - SET 2 1/2-INCH DIAM. ALUMINUM CAP ON 2-INCH DIAM. ALUMINUM PIPE 30 INCHES LONG AT REESTABLISHED CORNER POSITION AS DESCRIBED ON THE ACCOMPANYING CERTIFIED REMONUMENTATION RECORD FILED SEPARATELY.
- FOUND UNRECORDED 2 1/2-INCH DIAM. BRASS CAP ON A 1-INCH DIAM. IRON PIPE 30 INCHES LONG SET BY J. R. MITCHELL, EXPERIENCED CORNER RECOVERY TECHNICIAN, NOT REMONUMENTED.
- FOUND ORIGINAL CORNER POSITION - NOT REMONUMENTED.
- CORNER SEARCHED FOR AND NOT FOUND - NOT REESTABLISHED.
- FOUND 3/4-INCH DIAM. BRASS CAP ON A 3-INCH DIAM. IRON PIPE IN A SURROUNDING ROCK MOUND SET BY GLO. DEPUTY SURVEYOR LINCOLN E. WILKES IN 1924 AND MAINTAINED TO U.S.F.S. STANDARDS BY THE UNDERSIGNED W.L. HANLEY IN 1984.
- FOUND A 2 1/2-INCH DIAM. ALUMINUM CAP ON A 2-INCH DIAM. ALUMINUM PIPE IN A SMALL SURROUNDING ROCK MOUND SET BY THE UNDERSIGNED W.L. HANLEY ON SEPT. 27, 1984.
- CLAIM CORNER OR END CENTER DESIGNATION - E = EAST END CENTER, W = WEST END CENTER, I = CORNER ONE.
- RECORD OF ORIGINAL MINERAL SURVEY - SEE HISTORY FOR PERTAINING U.S. DEPUTY MINERAL SURVEYOR.
- RECORD OF SURVEY PERFORMED BY L.L. MYERS, ORLS 699, AND RECORDED AS BAKER COUNTY SURVEY NO. 9-37-15.
- RECORD OF SURVEY PERFORMED BY THE UNDERSIGNED W.L. HANLEY, ORLS 1639, IN 1985 AND RECORDED AS BAKER COUNTY SURVEY NO. 9-37-85.
- NATIONAL FOREST BOUNDARY MARKED WITH 6-FOOT LONG STEEL FENCE POSTS SPACED AT APPROXIMATELY 200-FOOT INTERVALS WITH USFS BOUNDARY SIGNS 34-2 ATTACHED.
- FOREST ACCESS ROAD.
- REFERENCE TO "METHOD OF LOST CORNER REESTABLISHMENT" ON SHEET 2 OF 2.

HISTORY OF SURVEYS

THE NORTH AND EAST BOUNDARIES OF T.9S., R.36E., W.M. WERE ORIGINALLY ESTABLISHED BY EUGENE P. MCCORMACK UNDER GLO. CONTRACT NO. 358 DATED JULY 2, 1881. THE NORTH BOUNDARY OF THE SAID TOWNSHIP WAS RESURVEYED BY OTIS GOULD UNDER INSTRUCTIONS INCLUDED IN GROUP NO. 179 DATED MARCH 17, 1936.

THE SOUTH AND WEST BOUNDARIES OF T.9S., R.37E., W.M. WERE SURVEYED BY LINCOLN E. WILKES UNDER INSTRUCTIONS INCLUDED IN GROUP NO. 107 DATED SEPT. 24, 1923. (THE NORTH HALF OF T.9S., R.37E., W.M., IS UNSURVEYED.)

MS 177, MOUNTAIN BELLE LODGE, WAS SURVEYED BY C.M. FOSTER UNDER INSTRUCTIONS DATED SEPT. 06, 1888.

MS 329, BUNKER HILL LODGE, WAS SURVEYED BY C.M. FOSTER UNDER INSTRUCTIONS DATED NOV. 04, 1896.

MS 375, MYRTLE LODGE, AND MS 376, LILAC LODGE, WERE SURVEYED CONCURRENTLY BY JOHN HAGEL UNDER INSTRUCTIONS DATED SEPT. 18, 1899.

MS 378, WIDE WEST, CENTURY AND CHARLESTON LODGES WERE SURVEYED BY JOHN HAGEL UNDER INSTRUCTIONS DATED OCT. 19, 1899.

MS 382A & B, ANNULULU LODGE AND ANNULULU MILLSITE, WERE SURVEYED BY C.M. FOSTER UNDER INSTRUCTIONS DATED DEC. 07, 1899.

MS 447, RAINBOW AND BOULDER LODGES, WERE SURVEYED BY C.M. FOSTER UNDER INSTRUCTIONS DATED SEPT. 25, 1901.

MS 480, AMAZON, BROOKLYN AND CUPID LODGES, KNOWN AS THE AMAZON GROUP, WAS SURVEYED BY JOHN HAGEL UNDER INSTRUCTIONS DATED JUNE 30, 1902.

MS 653A & B, ORLEANS LODGE AND ORLEANS MILLSITE, WERE SURVEYED BY W.M. W. ELMER UNDER INSTRUCTIONS DATED NOV. 28, 1905.

MS 745, SILVER DICK AND BLUE SWAN LODGES, WERE SURVEYED BY IRA L. HOFFMAN UNDER INSTRUCTIONS DATED JULY 12, 1911.

THE BROOKLYN LODGE, A PART OF MS 480, WAS RESURVEYED BY L.L. MYERS IN 1970 AND HIS RECORD OF SURVEY IS FILED UNDER BAKER COUNTY SURVEY NO. 9-37-15.

SEVERAL MINERAL SURVEY CORNERS WERE PREVIOUSLY RECOVERED AND REMONUMENTED BY J. R. MITCHELL, EXPERIENCED CORNER RECOVERY TECHNICIAN, AS SHOWN ON THIS PLAT (SHEET NOS. 1 & 2 OF 2). THESE UNRECORDED MONUMENTS WERE REMOVED AND REMONUMENTED BY THE UNDERSIGNED W.L. HANLEY AS A PART OF THIS CONTRACT.


NOTES FOR RECORD OF CORNER MONUMENTATION SEE CERTIFIED RECORD OF LAND CORNER MONUMENTATION FILED SEPARATELY.

FOR SURVEY NARRATIVE AND METHOD OF LOST CORNER REESTABLISHMENT SEE SHEET 2 OF 2.

SURVEYOR'S CERTIFICATE


I, WILLIAM L. HANLEY, A REGISTERED LAND SURVEYOR IN THE STATE OF OREGON, DO HEREBY CERTIFY THAT THIS PLAT (CONSISTING OF SHEET NOS. 1 & 2 OF 2), AND THE CERTIFIED RECORD OF LAND CORNER MONUMENTATION CERTIFICATES ACCOMPANYING THIS PLAT FILED SEPARATELY, IS A TRUE REPRESENTATION OF A SURVEY PERFORMED BY ME AT THE REQUEST OF THE USDA - FOREST SERVICE IN FULL CONFORMANCE WITH THE STATUTES OF THE STATE OF OREGON AND WITH THE ARTICLES OF MY CONTRACT.

William L. Hanley
WILLIAM L. HANLEY, OWNER
BILL HANLEY SURVEYING CO.
OREGON LICENSE NO. 1639

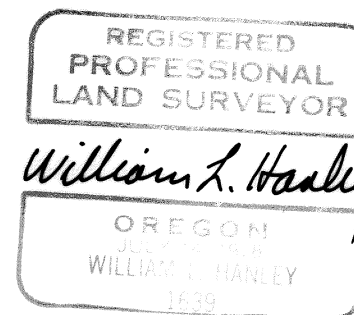

FIELD BOOK REFERENCES

FIELD BOOK NOS. 1, 2 & 3, SNELL HOLLOW CADASTRAL SURVEY

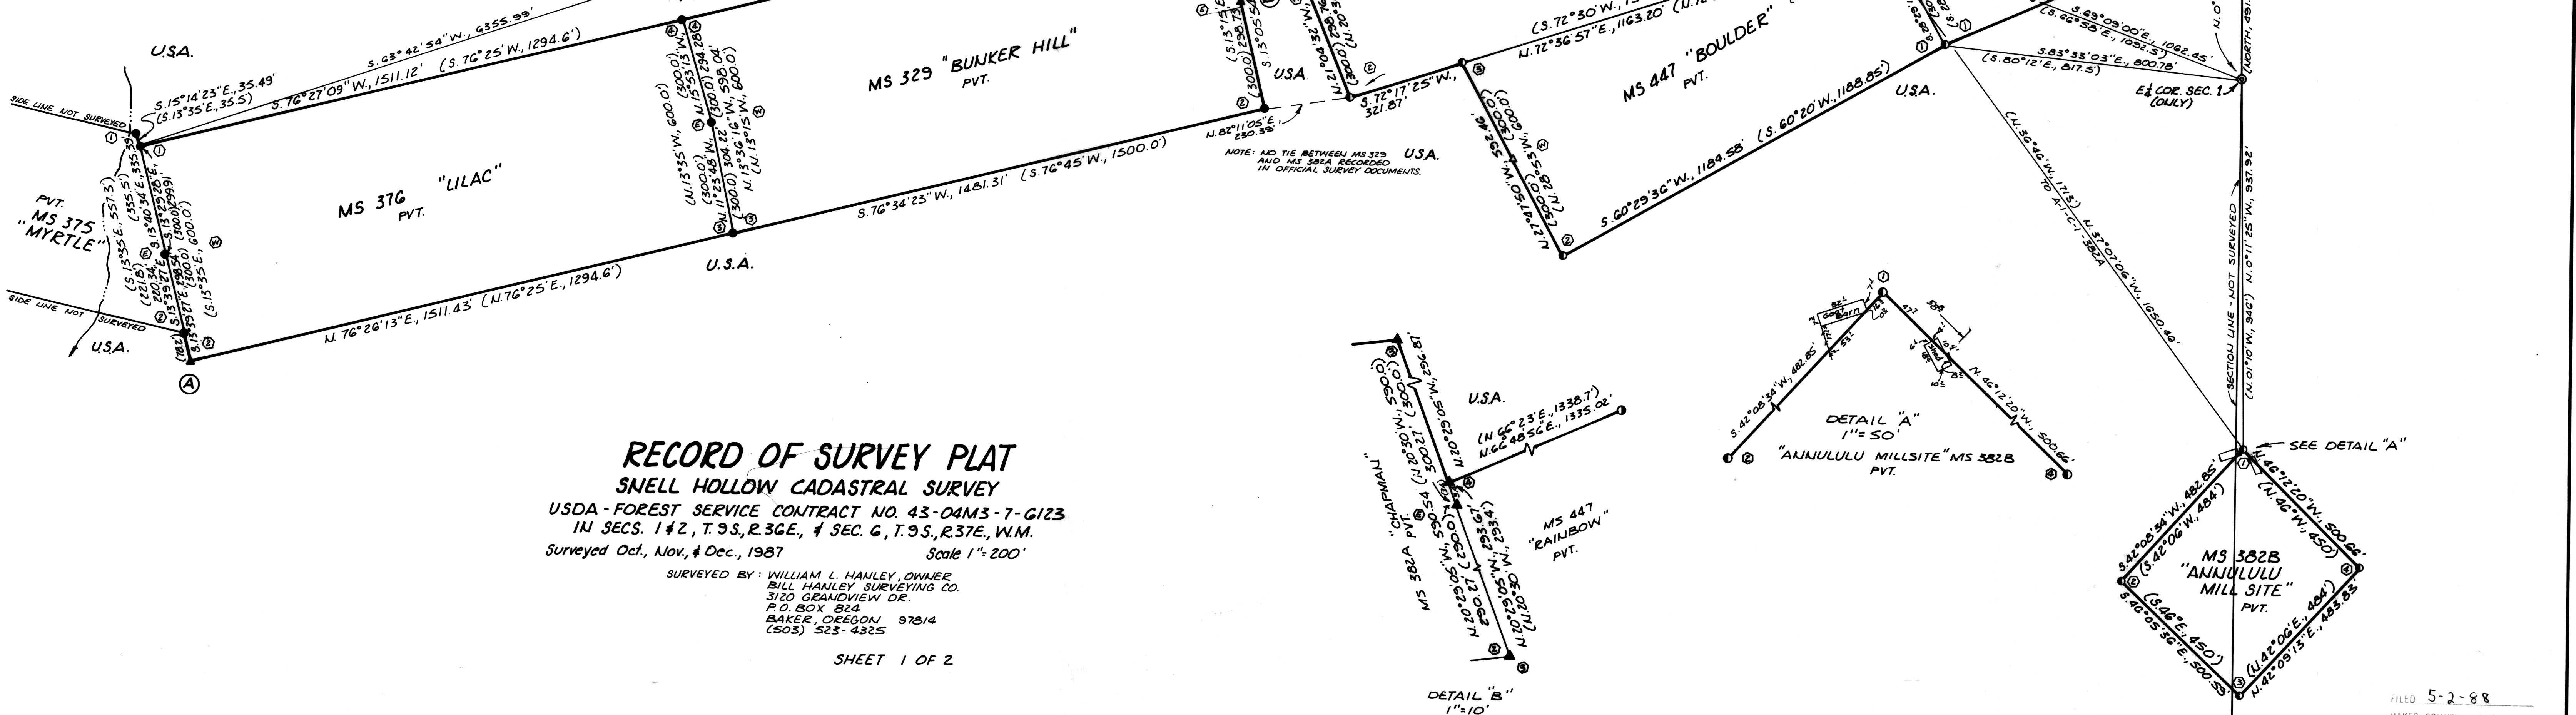

RECORD OF SURVEY PLAT
SNELL HOLLOW CADASTRAL SURVEY
USDA - FOREST SERVICE CONTRACT NO. 43-04M3-7-G123
IN SECS. 1 & 2, T.9S., R.36E., & SEC. 6, T.9S., R.37E., W.M.
Surveyed Oct., Nov., & Dec., 1987 Scale 1" = 200'

SURVEYED BY: WILLIAM L. HANLEY, OWNER
BILL HANLEY SURVEYING CO.
3120 GRANDVIEW DR.
P.O. BOX 834
BAKER, OREGON 97814
(503) 523-4325

SHEET 1 OF 2

BEARINGS ARE BASED ON A SOLAR OBSERVATION TAKEN AT CONTROL POINT NO. 101 WHICH BEARS S. 76° 34' 55" W., 1050.26 FEET DISTANCE FROM CORNER NO. 2, BUNKER HILL QUARTER CLAIM, MS 329, IN THE SW 1/4 OF SECTION 1, T.9S., R.36E., W.M. THE MEAN MEASURED MAGNETIC DECLINATION IS 20° EAST.

0 50' 100' 200'
MAP SCALE IN FEET
1 INCH = 200' FT.

