


CERTIFIED RECORD OF LAND CORNER MONUMENTATION

West center end, Bunker Hill Lode, MS 329 identical with
 East center end, Lilac Lode, MS 376
 History of original corner establishment:

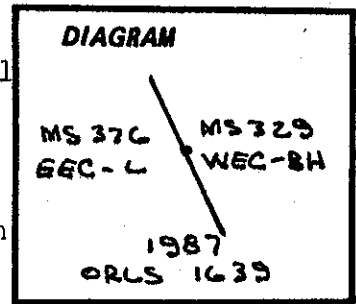

Corner ESTABLISHED by C.M.Foster, U.S. Deputy Mineral Surveyor, under instructions dated November 4, 1896, for the survey of the BUNKER HILL QUARTZ CLAIM, MS 329.

Surveyor General records state: Thence N13°15'W along east end line of the Lilac Claim(unsurveyed) center end post on West end of claim.

Corner AMMEMDED and perpetuated by John Hagel, U.S. Deputy Mineral Surveyor, under instructions dated September 18, 1899, for the survey of the LILAC QUARTZ CLAIM, MS 376.

Surveyor General records state: Identical with the east centre post of location and point of discovery. Identical with the west centre Bunker Hill Lode Sur 329. Found a fir post 4 ins square 3 ft above the ground marked Bunker Hill W.C.S.329 marked it Lilac E.C.S.376 for East centre post. A bl pine tree 8 ins in diam blazed Lilac ECS 376 BT brs N54°20'E, 28.0 ft. Mouth of tunnel No 1 brs S71°50'W, 539.0 ft, mouth of tunnel No 2 brs S69°W, 538.7 ft.

No trace of original fir post.

Lodgepole pine wind blow scribed "ECS...BT...376" on partially healed blaze (record of MS 376 EEC states, N54°20'E, 28.0')

Western larch snag 20" diam with fragmentary scribes brs S53°E, 13.6' marked "W. CENTRE...BT" on partially healed blaze (no record of this BT in original notes for survey of MS 329. Bearing and distance measured from true corner point.)

Description of monument and accessories I established to perpetuate the original location of this corner:

At position determined by reversed record bearing and distance from MS 376 EEC bearing tree windblow...

Set 2½" x 30" aluminum pipe with 2" aluminum cap 25" in ground with 5" projecting out of ground surrounded with rock mound. Cap marked as shown in corner diagram. Set steel fence post alongside with signs 54-9 attached.

New bearing trees established:

Lodgepole pine 6" dia brs S75°W, 4.1' mkd L-EEC-376 BT.

Lodgepole pine 7" dia brs N89°E, 28.0' mkd BH-WEC-329 BT.

New bearing trees have a brass washer stamped PLS 1639 nailed to face of blaze. Attached signs 54-3 & 54-9 and painted face of blaze and 6" band of red paint around each BT.

Compass declination 20° East.

I hereby certify that the above corner monument was properly REMONUMENTED to U.S.F.S. standards by me and witnessed by Bill Gohring on October 13, 1987.

**REGISTERED
PROFESSIONAL
LAND SURVEYOR**

William L. Hanley

**OREGON
JULY 14, 1978
WILLIAM L. HANLEY
1639**

Office of.....County Surveyor.....County of.....Baker
 Oregon
 State of....., I hereby certify that the within instrument was filed in this office
 for record on the..... day of....., 19....

..... by
 (COUNTY OFFICIAL) (DEPUTY)