


CERTIFIED RECORD OF LAND CORNER MONUMENTATION

Cor.No.2 Lilac Lode MS 376

History of original corner establishment:

Corner ESTABLISHED by John Hagel, U.S. Deputy Mineral Surveyor, under instructions dated September 18, 1899, for the survey of the LILAC QUARTZ CLAIM, MS 376, performed in conjunction with the survey of the MYRTLE QUARTZ CLAIM, MS 375, under instructions dated the same date.

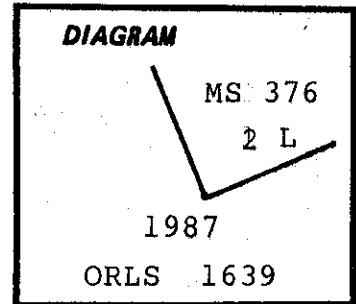

Surveyor General records state:

Identical with the SW cor of location...Set a tamarack post 4" square 4½ ft long 18" in ground with mound of earth around it marked "Lilac Cor 2-376" for Cor No 2.

A tamarack tree 12 ins in diam bears N81°W, 15.4 ft.

A tamarack tree 10 ins in diam bears S16°W, 19.0 ft.

Both blazed and marked "Lilac Cor 2-376 BT."

Description of corner evidence found:

Found no trace of original corner in area obliterated by previous logging activities.

NOTE: The record accessories for this corner are recorded exactly as those for "MYRTLE" Corner No 2, MS 375 (which are accurate as recovered this survey) and their reference for this corner is rejected.

Description of monument and accessories I established to perpetuate the original location of this corner:

At position determined by survey...

Set 2" x 30" aluminum pipe with 2½" aluminum cap 25" in ground with 5" projecting out of the ground surrounded with rock mound. Cap marked as shown in corner diagram. Set steel fence post alongside with signs 54-2 & 54-9 attached.

New bearing trees established:

A lodgepole pine 12" dia brs S88½°E, 36.6' mkd L-2-376 BT.

A lodgepole pine 11" dia brs S18½°E, 22.7' mkd L-2-376 BT.

New bearing trees have a brass washer stamped PLS 1639 nailed to face of blaze. Attached signs 54-3 & 54-9 and painted face of blaze and 6" band of red paint around each BT.

Compass declination 20° East.

I hereby certify that the above corner monument was properly REESTABLISHED by U.S.F.S. standards by me and witnessed by Bill Gohring on November 17, 1987.

REGISTERED
PROFESSIONAL
LAND SURVEYOR

William L. Hanley

OREGON
JULY 14, 1978
WILLIAM L. HANLEY
1639

Office of...County Surveyor.....County of...Baker
State of...Oregon....., I hereby certify that the within instrument was filed in this office
for record on the..... day of....., 19.....

..... by
(COUNTY OFFICIAL) (DEPUTY)

FILED 5-2-88
BAKER COUNTY SURVEYOR
SURVEY NO. 9-36-111