


CERTIFIED RECORD OF LAND CORNER MONUMENTATION

Cor.No.4,Annululu Lode,identical with Cor.No.4 Chapman Lode,MS 382A

History of original corner establishment:

This corner was ESTABLISHED in 1899 by C.M.Foster,
U.S. deputy mineral surveyor, as follows:

To cor.No.4. A pine post 4 ft long 4 ins square,
set 18 ins in the ground scribed 4-382-A. whence,
A pine 6 ins dia bears N73°W, 15.5 ft dist blazed
and scribed 4-382-A, B.T.

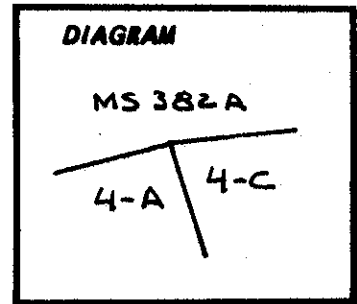

Description of corner evidence found:

None.

**Description of monument and accessories I established to perpetuate the
original location of this corner:**

At position determined by survey (see Record of Survey Plat filed
separately for method of corner position reestablishment)...

Set 2" x 30" aluminum pipe with 2½" dia aluminum cap attached 25"
in ground surrounded with a mound of earth & stone and placed 6'
steel fence post alongside with signs 54-9 attached.

Aluminum cap marked as shown to the right...

New bearing trees established:

A western larch 7" dia brs S83°W, 28.5' dist mkd A-4-C-4-382A BT.
A lodgepole pine 7" dia brs N33°E, 4.7' dist mkd A-4-C-4-382A BT.

Each new bearing tree has signs 54-3 & 54-9 attached below a
surrounding 6" band of red paint and has a brass washer marked
PLS 1639 nailed flush to red painted blaze.


Compass declination 20° East.

I hereby certify that the above described
corner was REESTABLISHED and MONUMENTED to
USFS standards by me and witnessed by
Bill Gohring on December 17, 1987.

REGISTERED
PROFESSIONAL
LAND SURVEYOR

William L. Hanley

OREGON
JULY 14, 1978
WILLIAM L. HANLEY
1639

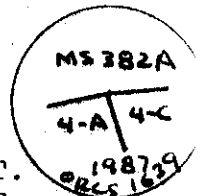

Office of.....County.....Surveyor..... County of.....Baker.....
State of.....Oregon....., I hereby certify that the within instrument was filed in this office
for record on the..... day of....., 19.....

..... by
(COUNTY OFFICIAL) (DEPUTY)

FILED 5-2-88
BAKER COUNTY SURVEYOR
SURVEY NO. 9-36-116