


CERTIFIED RECORD OF LAND CORNER MONUMENTATION

Cor.No.4,Rainbow Lode, MS 447.

History of original corner establishment:

This corner was ESTABLISHED in 1901 by C.M.Foster, U.S. deputy mineral surveyor, as follows:

To cor. No.4 On line 2-3 of Chapman Lode MS 382, A pine post 4½ ft long, 6 ins square, set 18 ins in the ground, surrounded with a mound of earth, scribed Rainbow 4-447.

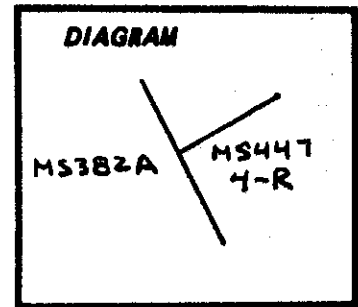

Description of corner evidence found:

A 10" diam lodgepole pine snag mkd RAINBOW-4-447 BT on partially healed blaze inside ½" overgrowth brs S86°E, 6.2' dist for corner point (blaze faces S50°W). There is no record of this BT in original mineral survey notes and it is therefore rejected.

Description of monument and accessories I established to perpetuate the original location of this corner:

At position determined by survey (see Record of Survey Plat filed separately for method of corner position reestablishment)...

Set 2" x 30" aluminum pipe with 2½" dia aluminum cap attached 25" in ground surrounded with a mound of earth & stone and placed 6' steel fence post alongside with signs 54-9 & 54-2 attached.

Aluminum cap marked as shown to the right...

New bearing trees established:


A lodgepole pine 9" diam brs N47°E, 69.9' dist mkd R-4-447 BT.

A lodgepole pine 10" diam brs N77°E, 79.5' dist mkd R-4-447 BT.


Each new bearing tree has signs 54-3 & 54-9 attached below a surrounding 6" band of red paint and has a brass washer marked PLS 1639 nailed flush to red painted blaze.

Compass declination 20° East.

I hereby certify that the above described corner was REESTABLISHED and MONUMENTED to USFS standards by me and witnessed by Bill Gohring on December 16, 1987.

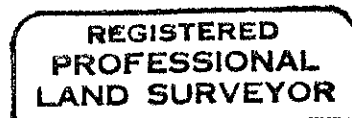

William L. Hanley

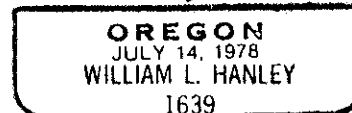

Office of.....County Surveyor.....County of.....Baker
State of.....Oregon....., I hereby certify that the within instrument was filed in this office
for record on the..... day of....., 19.....

..... by
(COUNTY OFFICIAL) (DEPUTY)

FILED 5-2-88

BAKER COUNTY SURVEYOR

SURVEY NO. 9-36-117