


CERTIFIED RECORD OF LAND CORNER MONUMENTATION

INDEX MS 813

History of original corner establishment:

- A. William W. Elmer, U.S. Deputy Mineral Surveyor, under Mineral Survey No. 813 surveyed the Elizabeth Dahl claim known as Pioneer, Pacific, and LaCross Lodes from 28 June, to 8 July, 1922 and approved by the U.S. Surveyor General's Office.

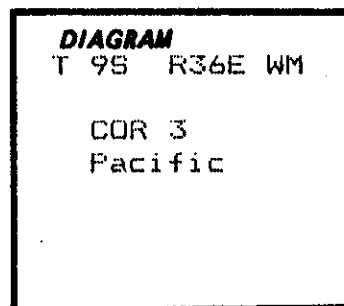

SURVEYOR GENERAL'S RECORD STATES:

A pine post 4 ins. square at the top, 4 ft. long, set 1.5 ft. in the ground with a mound of earth and stone, scribed 3-813-PACIFIC, whence
A tamarack 8 ins. dia. bears S25-30E., 27 ft., and
A tamarack 8 ins. dia. bears N81-30W., 19.1 ft. each blazed and scribed 3 813 PACIFIC BT

Description of corner evidence found:

B. MONUMENT FOUND:

I found the rotted remains of wood post on surface with axe marks visible and found pointed decaying end remains 4"x4"x12" post 14" in the ground.


ACCESSORIES FOUND:

11" dia. Western Larch (dead) leaning/windthrown with blaze and scribing visible of "813 PAC BT" bears S25-30E 27 ft.
Root collar and hole of tamarack bears N81-30W at 19 ft.

Description of monument and accessories I established to perpetuate the original location of this corner:

CORNER WORK DONE ON 6/13/90


- C. At the position of the pointed post remnant, set a 2.5" dia. by 30" long aluminum pipe with a 2.5" dia. aluminum cap. The pipe is set 24" in the ground with 6" exposure. No stones available. The cap is marked:

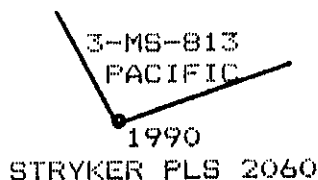

NEW ACCESSORIES ESTABLISHED

- 8" dia. Lodgepole Pine bears N60W, 5.0 ft.; scribed 3 MS 813 PACIFIC BT
- 8" dia. Lodgepole Pine bears S67E, 18.7 ft., scribed 3 MS 813 PACIFIC BT
- Painted the blaze red on each BT
- Painted a 6" wide red band around each BT
- Placed brass washer marked "PLS 2060" at base of each BT blaze
- Placed metal sign with bearing and distance information on each BT (54-3)
- Placed metal ATTENTION sign on each BT (54-4)
- Placed 6 ft. metal guard post at corner with metal PROPERTY BOUNDARY sign and metal ATTENTION sign (54-2 and 54-4)
- I measured to the centerline of each bearing tree using tape and hand compass with declination set at 20 degrees east.

Office of..... County of.....
State of..... I hereby certify that the within instrument was filed in this office
for record on the..... day of....., 19.....
..... by
(COUNTY OFFICIAL) (DEPUTY)

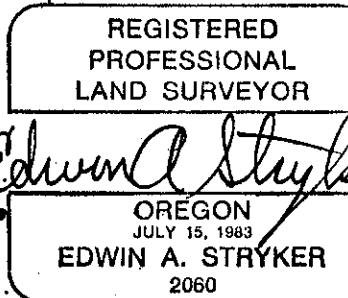

FILED 11-16-1990
BAKER COUNTY SURVEYOR
SURVEY NO. 9-36-129