


**R.O.S. DEVIL'S DREAM**  
**WITHIN**  
**SEC. 15, T.9S., R.36E., W.M.**

**NARRATIVE**


William Wells, ORS No. 1106, retraced the Devils Dream Mining Claim, in 1986, under contract to the US Forest Service, and remonumented the claim corners per record of survey number 9-36-71, records of Baker County Surveyor's Office. The purpose of my survey was to tie the existing road location to the monumented and posted boundary of said claim, so that right-of-way could be pursued by the Forest Service. I recovered W. Wells remonumented corners and these corners form the basis of this survey. My survey was a closed loop survey along the boundary of the Devils Dream mineral claim through said corners, using a WILD T1 theodolite and WILD DI-4L EDM. The existing centerline of native surface road was tied using a Topcon GTS-2R theodolite as part of this survey. The intersection of the mineral survey boundary and the existing road centerline was monumented to contract specifications, for the purpose of right-of-way. The survey was performed at the request of the USDA Forest Service.

BASIS OF BEARINGS  
 ROS 9-36-71 W. Wells  
 BETWEEN CORNERS 1 AND 2

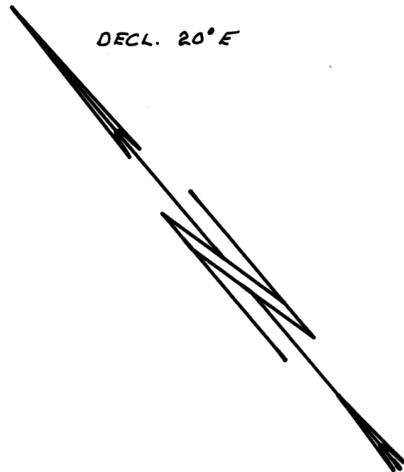

LINE	BEARING	DISTANCE
1	N 02°09'32"E	5.50

USDA

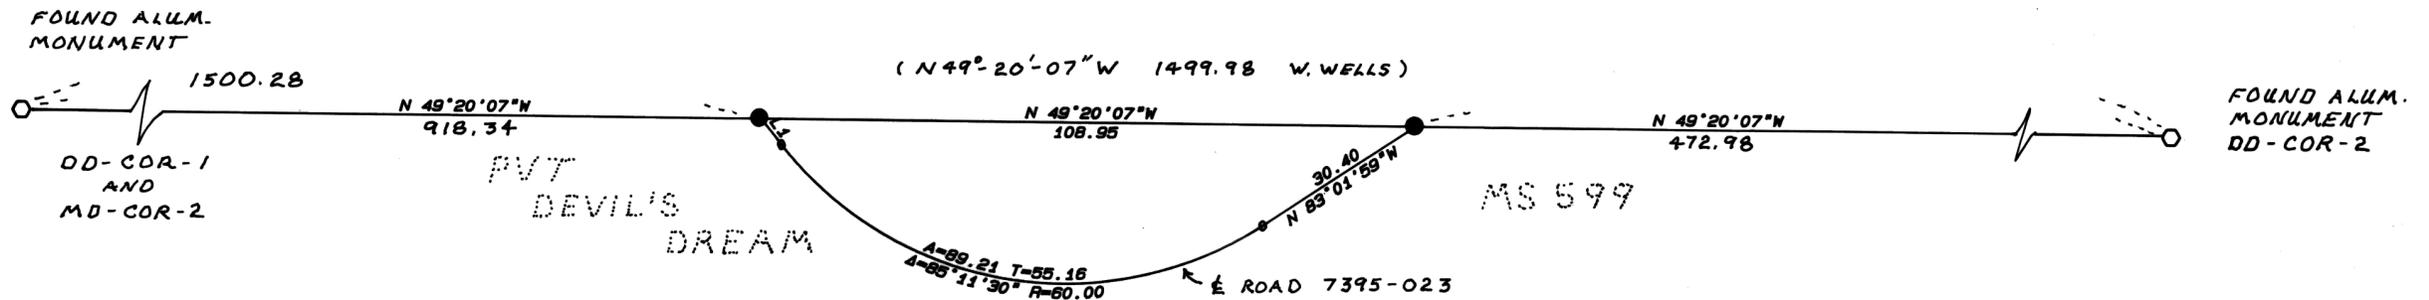

FILED 11-16-1990  
 BAKER COUNTY SURVEYOR  
 SURVEY NO. 9-36-136

**LEGEND**

- FOUND MONUMENT OF RECORD
- SET #5 Rebar with 1.5 inch dia. alum cap--PLS 2060
- (\*\*\*) SURVEY DATA OF RECORD

**DOWNIE CADASTRAL SURVEY**

CONTRACT NO.: 04M3-9-6056

REGISTERED  
 PROFESSIONAL  
 LAND SURVEYOR

*Edwin A. Stryker*

OREGON  
 JULY 15, 1983  
 EDWIN A. STRYKER  
 2060

**STRYKER-KIMBELL ASSOCIATES**

67918 HUNTER ROAD  
 SUMMERVILLE, ORE 97876  
 (503) 534-6905

DRAWN HP7575A	JOB NO 0689030936	DATED 8-25-90
CHECKED BY EAS	SCALE 1 in. = 20	SHEET 5 OF 5