

CERTIFIED RECORD OF LAND CORNER MONUMENTATION

History of original corner establishment:

Corner established by C.M.Foster, U.S. Deputy Mineral Surveyor, under instructions dated November 4, 1896, for the survey of the BUNKER HILL QUARTZ CLAIM, MS 329.

Surveyor General records state:

Thence S13°15'E, along West end line of Gone Case Claim (Unsurveyed).
Established Centre end post of claim.

Corner was remonumented by: William L. Hanley per Corner Record 9-36-109, dated 5-2-88

Original corner post not found.

A sawed rotting western larch stump 20" dia & 4.8' high brs S27°W, 14.7' dist marked "BT" on remaining blaze. (No record in MS 329 notes for this BT)

At midpoint between corner #1 and corner #2 of this claim as determined by survey...

Set a 2" x 30" aluminum pipe with a 2 1/2" aluminum cap 25" in ground with 5" projecting out of the ground surrounded with rock mound. Cap marked as shown in corner diagram. Set steel fence post alongside with signs 54-2 & 54-9 attached.

New bearing trees established:

A lodgepole pine 12" dia brs S58°E, 36.0' dist mkd BH-EEC-329 BT.

A lodgepole pine 6" dia brs N78°E, 61.0' dist mkd BH-EEC-329 BT.

New bearing trees have a brass washer stamped PLS 1639 nailed to face of blaze. Attached signs 54-3 & 54-9 and painted face of blaze red and 6" band around each BT.

Compass declination 20° East.

I hereby certify that the above corner monument was properly REESTABLISHED
o U.S.F.S. standards by me and witnessed by Bill Gohring on October 29, 1987.

T 9 S R 36 E
MS 329
EEC

**Bunker Hill
East End Center**

Continued on page 2 of 2

REGISTERED
PROFESSIONAL
LAND SURVEYOR

Kristina Powell

OREGON
MAY 9, 2017
KRISTINA POWELL
91201

EXPIRES 12-31-24

FILED January 3, 2024
BAKER COUNTY SURVEYOR
SURVEY NO. 9-36-138

CERTIFIED RECORD OF LAND CORNER MONUMENTATION

Description of corner evidence found:

A 2 inch aluminum pipe with a 2 1/2 inch aluminum cap, marked as shown. Firmly set 8 inches above ground, with a 2 ft. diam. by 1 ft. high mound of stone.

From which:

A rotten tamarack stump (by Foster), bears S27°W, 14.7 feet.


A 9 inch lodgepole pine snag (by Hanley) with open blaze scribed "BH EEC 329 BT", bears N78°E, 61.0 feet.

A 14 inch lodgepole pine snag (by Hanley) with open blaze scribed "BH EEC 329 BT", bears S58°E, 36.0 feet.


A steel T-post bears S15°E, 15.0 feet; with sign: Property Boundary.

A steel T-post bears N15°W, 15.0 feet; with two (2) signs: Property Boundary, Land Survey Monument.

Monument falls South 130 feet of the 030 Road, in North edge of old skid road at bottom of small cut bank.

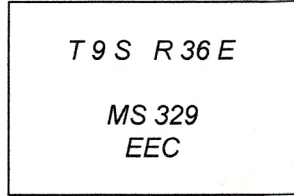

Bunker Hill East End Center

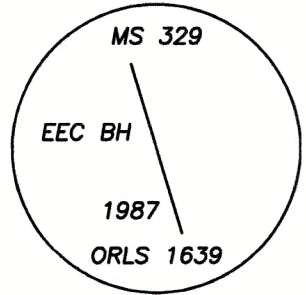

Description of monument and accessories I established to perpetuate original location of this corner:

New Bearing Trees:

A 12 inch tamarack scribed "EEC BH 329 BT" bears S9°E, 12.2 feet; measured to a 3/4 inch brass washer mkd: "LS 91201", at the right side of tree center.

A 12 inch Douglas fir scribed "EEC BH 329 BT" bears N64 1/2°W, 26.7 feet; measured to a 3/4 inch brass washer mkd: "LS 91201", at the right side of tree center.

Added Bearing Tree and Land Survey Monument signs as needed.

NAD 83 Geodetic Position

Lat. 44°48'36.0" N
Long. 118°14'45.1" W

Established by: Garmin ETREX 32x

I hereby certify that the corner is monumented and accessories taken as described using a steel tape and a Warren Knight staff compass, set with a declination of 14° East.

Witnesses: David Quittschreiber, Justin Seal

September 8, 2023

REGISTERED
PROFESSIONAL
LAND SURVEYOR

Kristina Powell

OREGON
MAY 9, 2017
KRISTINA POWELL
91201

EXPIRES 12-31-24

FILED January 3, 2024
BAKER COUNTY SURVEYOR
SURVEY NO. 9-36-138