


CERTIFIED RECORD OF LAND CORNER MONUMENTATION

INDEX No. W-11

History of original corner establishment:

Corner established this survey.

DIAGRAM

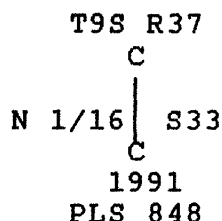

Description of corner evidence found:

Corner established this survey.


Description of monument and accessories I established to perpetuate the original location of this corner:

Set 2-1/2"x30" aluminum pipe with 3-1/2" aluminum cap, stamped as shown on the **DIAGRAM**, Set 22" in the ground and raised a mound of stone and earth around the monument.

From Which:

- A P. Pine, 12" in dia., bears N22°30'W, 5.0 ft., scribed: C-N 1/16 S33 BT
- A P. Pine, 12" in dia., bears S55°15'W, 28.5 ft., scribed: C-N 1/16 S33 BT

Nailed a brass washer stamped PLS 848 on blaze above BT scribe as taken this survey. Nailed Bearing Tree (54-3) signs above blaze and Land Survey Monument (54-9) signs on back of each tree as required. Painted a 6" red band above Bearing Trees signs. Measurements to BT's taken with a magnetic compass, declination 20° East, and a nylon clad steel tape. Set steel fence post with Land Survey Monument (54-9) and Property Boundary (54-2) signs 5' north and 5' east of the monument.

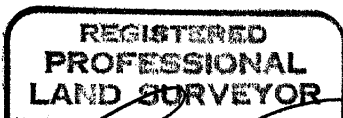

This work is performed by:  
Douglas M. Ferguson PLS 848  
Witnessed by:  
D. Mitchell Ferguson & Rick Saul  
March 29, 1991  
Refer to Baker Co. Survey No. 9-37-181

Office of \_\_\_\_\_ County of \_\_\_\_\_  
State of \_\_\_\_\_ I hereby certify that the within instrument was filed  
in this office for record on the \_\_\_\_\_ day of \_\_\_\_\_, 19\_\_\_\_ FILED \_\_\_\_\_ 1-22-92  
\_\_\_\_\_ by \_\_\_\_\_  
(COUNTY OFFICIAL) (DEPUTY) BAKER COUNTY SURVEYOR  
SURVEY NO. 9-37-204