

CERTIFIED RECORD OF LAND CORNER MONUMENTATION

INDEX No. X-15

History of original corner establishment:

Corner was originally established in 1978 by William L. Hanley under Baker County Survey Number 9-37-20. His record does not state what was set.

DIAGRAM

T9S R37E
C 1 S34
4
1981
ORLS 1639

In 1981, William L. Hanley re-established this corner's position. His record on the Certified Record of Land Corner Monumentation form, Baker County Survey Number 9-37-63, states:

Corner established by William L. Hanley, ORLS 1639, in the course of survey of Golden Chariot Estates subdivision. Found a 1½ inch iron pipe projecting 2½ feet out of the ground at a point which bears N5°W, 11.6 feet from proper corner location. Set a 2½ inch brass cap on a 1 inch iron pipe 31 inches long and projecting 5 inches out of the ground with a surrounding rock mound. Brass cap marked thus: (SEE DIAGRAM).

Description of corner evidence found:

Found 2½ ins. brass cap on a 1 inch iron pipe projecting 5 inches out of the ground in a mound of stone, marked as shown in DIAGRAM.

No accessories were established.


Description of monument and accessories I established to perpetuate the original location of this corner:

No work is needed on the monument.

From Which:

- A Ponderosa Pine, 10" in dia, bears N39°45'W, 16.1 ft, scribed: C1/4 S34 BT
- A Ponderosa Pine, 14" in dia, bears N14°00'E, 12.5 ft, scribed: C1/4 S34 BT
- A Ponderosa Pine, 10" in dia, bears S 8°30'E, 12.1 ft, scribed: C1/4 S34 BT
- A Ponderosa Pine, 10" in dia, bears S71°15'W, 11.4 ft, scribed: C1/4 S34 BT

Nailed a brass washer stamped PLS 848 on blaze above BT scribe as taken this survey. Nailed Bearing Tree (54-3) signs above blaze and Land Survey Monument (54-9) signs on back of each tree as required. Painted a 6" red band above Bearing Trees signs. Measurements to BT's taken with a magnetic compass, declination 20° East, and a nylon clad steel tape. Set steel fence post with Land Survey Monument (54-9) and Property Boundary (54-2) signs 5' south and 4' east of the monument.

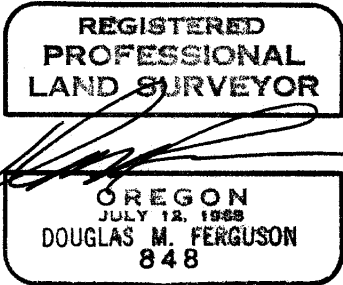

This work is performed by:
Douglas M. Ferguson PLS 848
Witnessed by:
D. Mitchell Ferguson & Rick Saul
April 1, 1991
Refer to Baker Co. Survey No. 9-37-181

Office of _____ County of _____
 State of _____ I hereby certify that the within instrument was filed
 in this office for record on the _____ day of _____, 19____ FILED _____ /-22-92
 _____ by _____
 (COUNTY OFFICIAL) (DEPUTY) BAKER COUNTY SURVEYOR
 SURVEY NO. 9-37-210