

**CERTIFIED RECORD OF LAND CORNER MONUMENTATION**


**HISTORY OF ORIGINAL CORNER ESTABLISHMENT:**

Corner established by Herman D. Gradon under GLO contract No. 416, dated August 19, 1881.

Corner was re-established by James Hanley, OPLS 1206, in July 1980, County Survey 9-37-60.

In this survey, a 2-1/2-inch diameter brass cap on 2-inch iron pipe in mound of stone was set, also two new bearing trees as described:

- A 12-inch pine bears N. 19° W., 28.8 feet distance, marked S 1/4 S20 BT.
- A 7 inch fir bears S 56° W., 67.5 feet distance, marked N 1/4 S 29 BT.

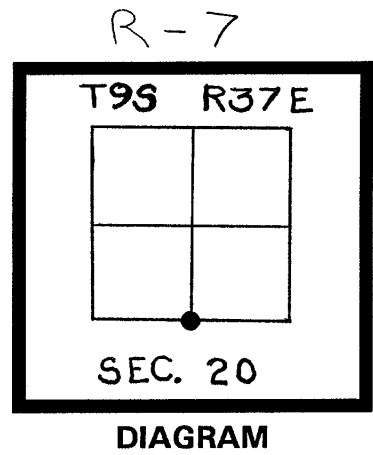


**DESCRIPTION OF CORNER EVIDENCE FOUND:**

Found mound of stone intact and above-mentioned bearing trees in place. Brass cap monument was missing.

**DESCRIPTION OF MONUMENT AND ACCESSORIES I ESTABLISHED TO PERPETUATE THE ORIGINAL LOCATION OF THIS CORNER:**

Set a 2-1/2-inch diameter aluminum cap on a 2-1/2-inch x 30-inch aluminum pipe in existing mound of stone.

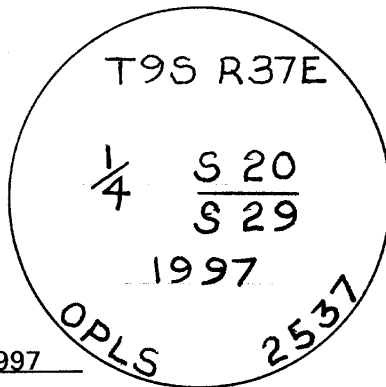

I hereby certify that the above corner point was perpetuated as hereon described on June 20, 1997

Witnesses: Pete Elder, LSIT

REGISTERED PROFESSIONAL LAND SURVEYOR

*H. Mc*

OREGON  
JAN. 21, 1992  
HARMON E. McLENDON  
2537

Renews 12/31/98

FILED AUG 1, 1997  
BAKER COUNTY SURVEYOR  
SURVEY NO. 9-37-250