


CERTIFIED RECORD OF LAND CORNER MONUMENTATION

Z-17

History of original corner establishment:

Corner originally established in 1881 by Eugene P. McCormack under GLO Contract No. 398. Surveyor General records state: Set Post 4 ft long 4 ins square 24 ins in the ground for cor to secs 2, 3, 34 and 35 marked T9S S35 on NE, R37E S2 on SE, T10S S3 on SW and S34 on NW faces with 2 notches on E and 4 notches on W edges from which
A Pine 30 ins diam bears N20°E 30 lks dist marked T9S R37E S35 BT
A Pine 30 ins diam bears S65°E 36 lks dist marked T10S R37E S2 BT
A Pine 24 ins diam bears N40°W 56 lks dist marked T9S R37E S34 BT
No other tree within limits dug pit in sec 3

DIAGRAM

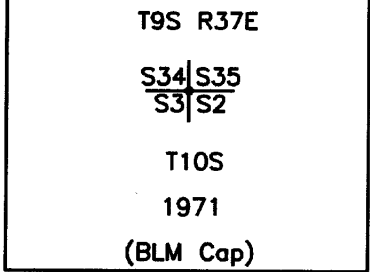

In 1971 the BLM replaced the original corner post with an I.P. 2 1/2" x 30", 24" in the ground marked as shown in the corner diagram. They reset the original corner post alongside the I.P. and deposited a granite stone 5" x 5" x 4" with an X chiseled on the west face. An unrecorded steel post 1" diameter x 24" long found beside the post was reset alongside the I.P.

Description of corner evidence found:

- 2 1/2" iron pipe with brass cap stamped as shown in corner diagram, 1" above ground. Corner monument is solid, cap scarred by heavy equipment. Bearing trees established by the BLM in 1971:
- 13" Ponderosa Pine, 7' high dead snag with healed blaze, bears N67°E 104 links distance.
- 13" Ponderosa Pine, dead and down with healed blaze, bears S36°E 72 links distance.
- 14" Ponderosa Pine, with healed blaze, bears S7°W 78 links distance.
- 13" Ponderosa Pine, 7' high dead snag with healed blaze, bears N36°W 78 links distance.

Original bearing trees:

- 23" Ponderosa Pine, stump with visible scribing, bears N20°E 30 links distance.
- 23" Ponderosa Pine, stump with no visible scribing, bears S60°E 36 links distance (Record S65°E).
- 20" Ponderosa Pine, stump out of ground with no visible scribing, bears N40°W 56 links distance.

Description of monument and accessories I established to perpetuate the original location of this corner:

Set 6' aluminum fencepost with 54-2 and 54-9 signs 5' east of corner monument.

New bearing trees established:

- 9" Ponderosa Pine bears N18°W 23.5' distance scribed T9S R37E S34 BT.
- 10" Ponderosa Pine bears S29°E 44.3' distance scribed T10S R37E S2 BT.
- 7" Ponderosa Pine bears N68°E 27.6' distance scribed X BT (Only suitable tree in NE quadrant, too small to scribe properly).

New bearing trees have a brass washer stamped PLS 2672 nailed to face of blaze. Attached 54-3 and 54-9 signs to each bearing tree and painted face of blaze and a 6" band around each bearing tree. The distance is measured to a 50d nail in side center of bearing trees.

Compass declination 18° East.

Date: July 24, 1997



Kenneth A. Lind



Renews 12/31/98

FILED 9-9-97
BAKER COUNTY SURVEYOR
SURVEY NO. 9-37-253

Office of.....County Surveyor..... County of.....Baker.....
State of.....Oregon....., I hereby certify that the within was filed in this office
for record on the..... day of....., 19.....

..... by
(COUNTY OFFICIAL) (DEPUTY)