


CERTIFIED RECORD OF LAND CORNER MONUMENTATION

Z-21

History of original corner establishment:

Corner originally established in 1881 by Eugene P. McCormack under GLO Contract No. 398. Surveyor General records state: Set Post 4 ft long 4 ins square 24 ins in the ground for cor to secs 1, 2, 35 and 36 marked T9S S36 on NE, R37E S1 on SE, T10S S2 on SW and S35 on NW with notch on E and 5 notches on W edges from which

- A Pine 18 ins diam bears N32°E 15 lks dist marked T9S R37E S36 BT
- A Pine 18 ins diam bears S30°E 30 lks dist marked T10S R37E S1 BT
- A Pine 16 ins diam bears S5°W 12 lks dist marked T10S R37E S2 BT
- A Pine 20 ins diam bears N65°W 37 lks dist marked T9S R37E S35 BT

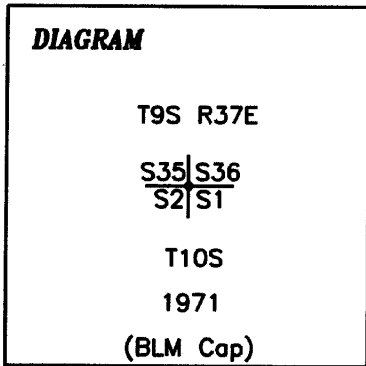

In 1971 the BLM determined the original corner location from the remains of the original bearing trees at record bearing and distance. At the original corner location they set an I.P. 2 1/2" x 30" 24" in the ground stamped as shown in the corner diagram.

Description of corner evidence found:

- 2 1/2" iron pipe with brass cap stamped as shown in corner diagram, 3" above ground. Corner monument is solid and in good condition. Bearing trees established by the BLM in 1971:
- 9" Ponderosa Pine, with visible scribing, bears N39°E 55 links distance.
- 14" Ponderosa Pine, with visible scribing, bears S32°E 45 links distance.
- 9" Ponderosa Pine, dead and down with visible scribing, bears S25°W 48 links distance.
- 12" Ponderosa Pine, with healed blaze, bears N77°W 54 links distance.

Original bearing trees:

- 22" Ponderosa Pine, 4' high stump with visible scribing, bears N43°E 15 links distance (Record N32°E).
- 20" Ponderosa Pine, 4' high stump with visible scribing, bears S27°E 30 links distance (Record S30°E).
- 18" Ponderosa Pine, 4' high stump with visible scribing, bears S9°W 12 links distance (Record S5°W).
- 24" Ponderosa Pine, 4' high stump with no visible scribing, bears N62°W 37 links distance (Record N65°W).

Description of monument and accessories I established to perpetuate the original location of this corner:

Set 6' aluminum fenceposts with 54-2 and 54-9 signs 5' east and 5' west of corner monument.

New bearing tree established:

11" Ponderosa Pine bears S81°W 16.4' distance scribed T10S R37E S2 BT.

New bearing tree has a brass washer stamped PLS 2672 nailed to face of blaze. Attached 54-3 and 54-9 signs to bearing tree and painted face of blaze and a 6" band around bearing tree. The distance is measured to a 50d nail in side center of bearing tree.

Compass declination 18° East.

Date: July 24, 1997



Kenneth A. Lind



Renews 12/31/98

FILED 9-9-97
BAKER COUNTY SURVEYOR
SURVEY NO. 9-37-255

Office of.....County..Surveyor..... County of.....Baker.....
State of.....Oregon....., I hereby certify that the within was filed in this office
for record on the..... day of....., 19.....
..... by
(COUNTY OFFICIAL) (DEPUTY)