




SURVEYS BY HANLEY ENGINEERING

Survey no.	For	Date	Description
9-37-11	Bruce Boyce	8-20-70	Lots A & B, Blk 7, South Sumpter Ellis Addn
9-37-12	Elmer Leppere	9-2-70	Lots 1, 2, 3, 5, 6, 8, 9 & 10, Blk 5, and lot 7 - W 1/2 Lot 8, Blk 6, Revised Townsite of Sumpter
9-37-13	PNW Bell	7-7-71	lot 10, Blk 6, Revised Townsite of Sumpter
9-37-14	Ray Call Inc	6-28-72	East Line Blks 9+11 and all Blks 14, 16 & 22, S.T.S. Warren Heights
9-37-15	Tom Gray	12-23-72	lots 1 & 2, Blk 2, S.T.S. Warren Heights Addn
9-37-16	Herb Hartwell	9-15-73	lots 1, 2, 3, 10, 11 & 12 and N 1/2 Lot 9, Blk 1, South Sumpter Ellis Addn
9-37-17	Stanley Cruise	5-14-74	lots 3 & 4, Blk 3, Sumpter Heights McEwens Addn
9-37-18	Stanley Cruise	7-1-74	lot 8 & W 1/2 lot 7, Blk 5, Sunnyside & Parkinsons Addn
9-37-19	Bemington	7-2-74	lots 1, 2, 7, 8, 9 & 10, Blk 7, Revised Townsite of Sumpter
9-37-110	Tom Gray	7-30-74	West Line lots 1-4, Blk 29, S.T.S. Warren Heights Addn
9-37-111	R.W. Thomas Estate	10-28-74	lots 1-7 & 14-20 and 3E Cor lot 10, Blk 27, S.T.S. First Addn
9-37-112	Tom Gray	5-20-75	East Line lots 1-4, Blk 29, S.T.S. Warren Heights Addn
9-37-113	Mel Barton	7-7-75	S.V.R. E/W of South Line Blk 7, South Sumpter Ellis Addn
9-37-114	Chas Baker	9-25-75	lots 1-4, Blk 2, Sunnyside & Parkinsons Addn
9-37-115	Alfred Slomo	4-8-77	lots 1-4, Blk 9, South Sumpter Ellis Addn
9-37-116	Vern Volant	12-22-77	lots 1-2 & 7-8, Blk 19, S.T.S. Warren Heights Addn
9-37-117	M.W. Burnette	6-8-79	lots 1-5, Blk 3, Sunnyside & Parkinson Addn

Found 1" IP in rock mount for Sec. Cor

MAP OF SUMPTER, OREG.
SURVEYS BY HANLEY ENGINEERING
Scale 1"=100' Sheet 1 of 3

FILED Sept. 17, 1970
SURVEY NO. 9-37-1

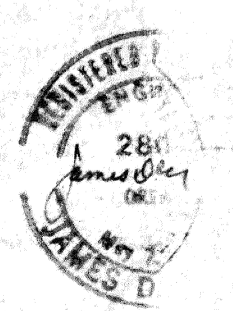

See Note Sheet 2