


MERIDIAN BY SOLAR OBS.

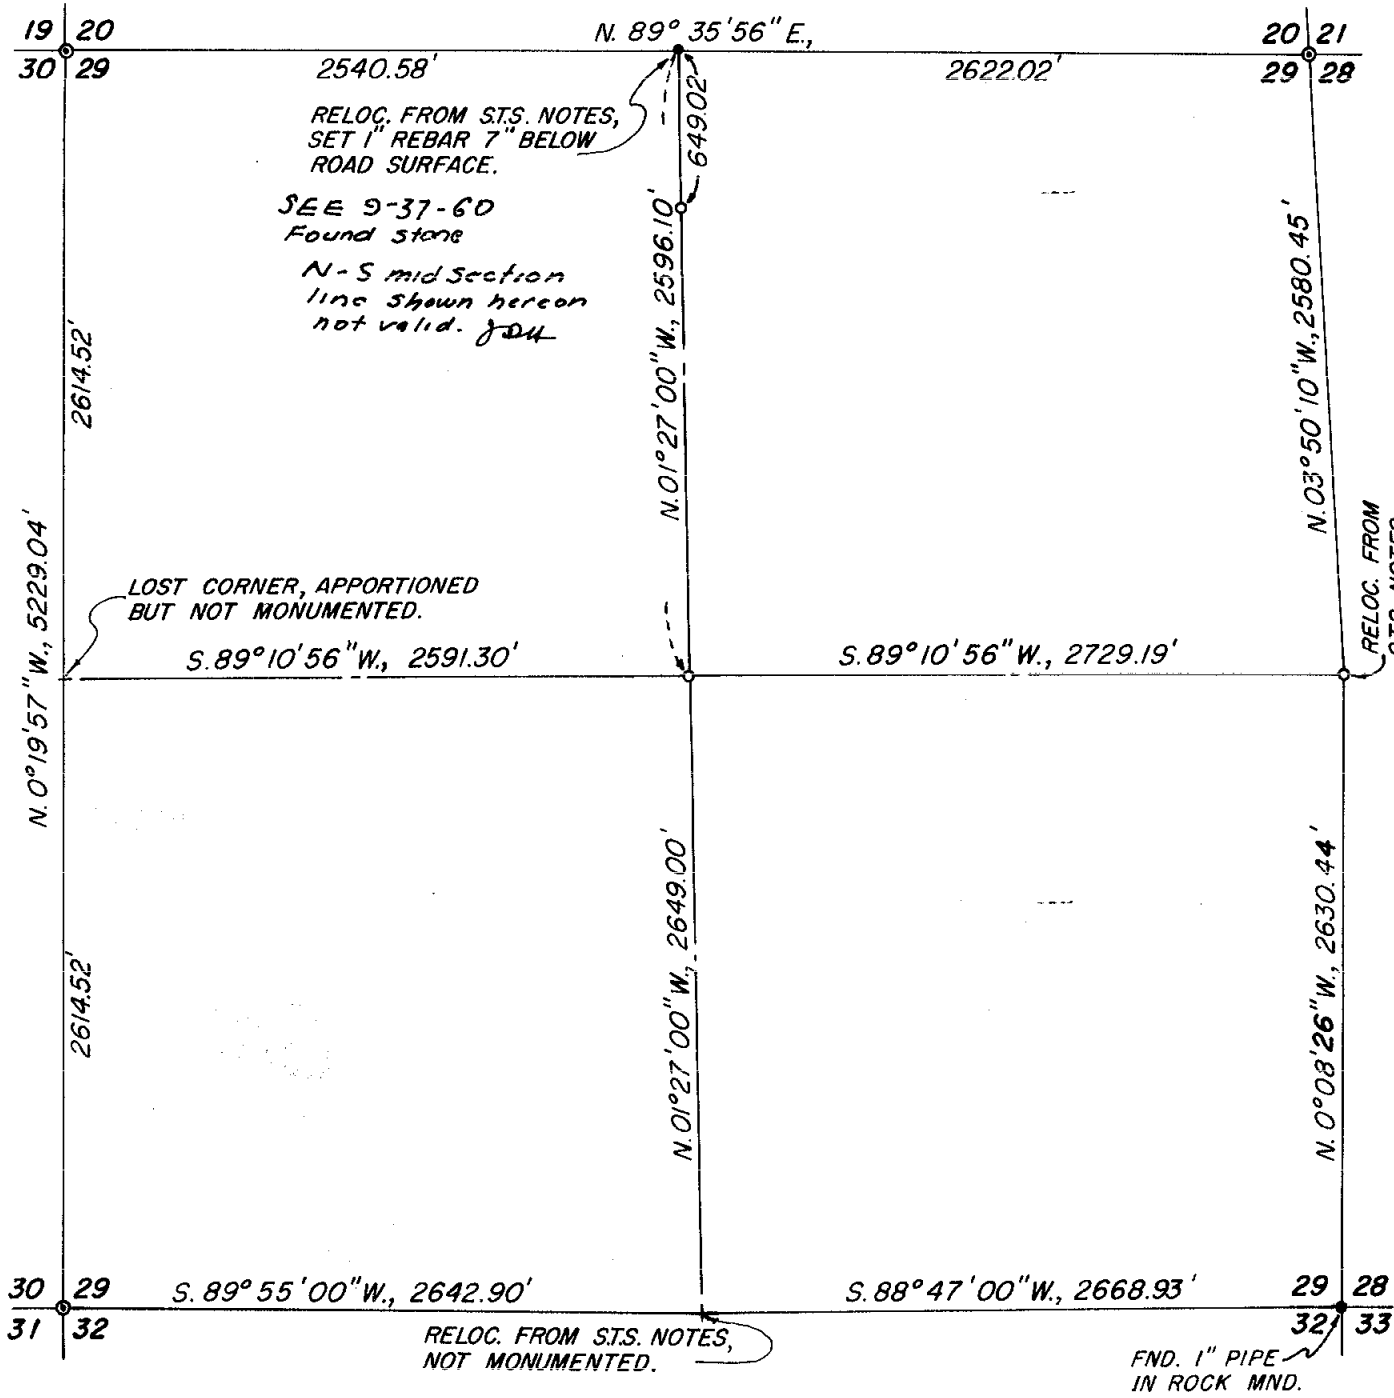


LEGEND:

- ⊙ Indicates Fnd. BLM Brass Cap Mon.
- Indicates Set 2" Alum. Cap on 1" Iron Post
- S.T.S. Indicates Sumpter Townsite Survey, 1899

MAP OF SURVEY
SUBDIVISION OF SEC. 29
T.9S., R.37E., W.M., BAKER CO., ORE.

Surveyed Aug. 25 - Sept. 14, 1971
 Sept. 23 - Oct. 22, 1974

Scale 1" = 800'
 For Dave A. Simonson

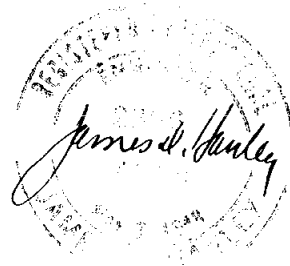

Oct. 28, 1974

SURVEY NO. 9-37-5