

# PLAT OF SURVEY

For ART KELLER  
October 20, 1970

By LELAND MYERS  
Scale 1" = 100'

Approx. Section Line



Basis of Bearings  
Magnetic 20° E. declination

Sec. 6, T9S, R37E

(1500.0'),  
1501.54  
S62° 01' 01" W  
(S60° 20' W)

(600.0'),  
602.18  
N28° 34' 05" W  
(N28° 34' W)

MS 480  
BRO.C.3 CUP.C.2  
AMA.C.4  
1970

Cupid

BROOKLYN  
MINERAL SURVEY 480

(1500.0'),  
1503.64  
N62° 04' 22" E  
(N60° 20' E)

Amazon

(600.0'),  
600.70,  
S28° 22' 10" E  
(S28° 34' E)


BRO.C.2  
AMA.C.1  
MS 480  
1970

(156.5)  
155.72

N27° 10' 58" W  
(Unknown)


AMA MS 480  
RAIN  
C.5 MS447  
1970

Rainbow

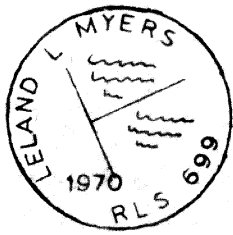

5/8" x 30" Rebar with aluminum cap

(Original distance & bearing in parenthesis)

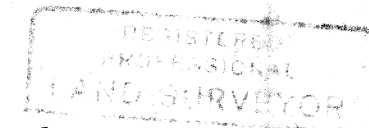

*Leland Lee Myers*  
LELAND MYERS

FILED Aug 31, 1977  
BAKER COUNTY SURVEYOR  
SURVEY NO. 9-37-15

**CERTIFICATION**

I hereby certify that I have found the corners of Brooklyn Lode of Mineral Survey 480 and the distances and Bearings are as measured by myself and crew and these to be true and correct to the best of my knowledge.