

CERTIFIED RECORD OF LAND CORNER MONUMENTATION

History of original corner establishment:


Mineral Survey No. 480 completed August 2, 1902

Identical with the S.W. cor. of the location. Identical with Cor. No. 1 of the "Amazon Lode" of this survey.

Set a tamarack post 5 ins. square 4 1/2 ft long 18 ins. in the ground scribed BRO.C.2, AMA.C.1 - Sur. 480 with a mound of earth around it.

A black pine tree 6 ins. in diam. blazed and scribed BRO.C.2-480 BT bears S80° 45'E, 12.3 ft.

A black pine tree 8 ins. in diam. blazed and scribed AMA.C.1-480 BT bears N55°E, 6.7 ft.

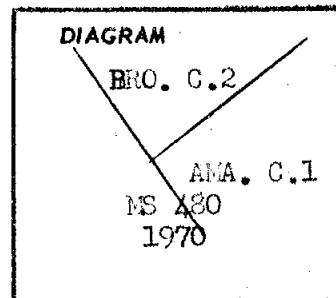

Description of corner evidence found:

None, apparently lost to logging activity about 1945.

Description of monument and accessories | established to perpetuate the original location of this corner

Using the west-end center post location, the bearing tree being a 12" Spruce that bears S49°W, 9.8 ft., which is not monumented, and Mineral Survey No. 447 Rainbow Lode Corner 5, the location of this corner was reestablished. Set a 5/8" x 30" rebar with a 2" aluminum cap marked as shown above for the corner.

REGISTERED
PROFESSIONAL
LAND SURVEYOR

Leland Lee Myers

OREGON
JULY 9, 1965
LELAND LEE MYERS
699

Office of..... County of.....
 State of....., I hereby certify that the within instrument was filed in this office
 for record on the day of....., 19....., at..... o'clockm., (signed)
 by
 (COUNTY OFFICIAL) (DEPUTY)

FILED Aug. 31, 1977
 BAKER COUNTY SURVEYOR
 SURVEY NO. 9-37-16