


CERTIFIED RECORD OF LAND CORNER MONUMENTATION

**History of original corner establishment:**

Mineral Survey No. 480 completed August 2, 1902

Identical with the S.E. cor. of the location.  
Identical with Cor. No. 4 of the "Amazon" Lode.  
Identical with Cor. No. 2 of the "Cupid" Lode of this survey.  
Set a pine post 5 ins. square  $\frac{1}{8}$  ft. long 18 ins. in the  
ground scribed BRO.C.3 - AMA.C.4 - CUP.C.2 - Sur. 480 with a  
mound of rock around it.

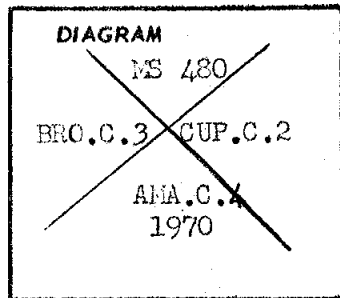

A tamarack tree 8 ins. in diam. blazed and scribed BRO.C.3-480 BT  
bears S31° 0'E, 20.2 ft.

A red fir tree 10 ins. in diam. blazed and scribed CUP.C.2-480 BT  
bears S82° 30'W, 44.5 ft.

A red fir tree 11 ins. in diam. blazed and scribed AMA.C.4-480 BT  
bears S84° 20'W (no distance given)

The mouth of tunnel No. 2 bears S76° 35'W, 448.5 ft.

**Description of corner evidence found:**

Found the rock mound and the post with scribing. The 8" tamarack BT  
is gone. The 10" red fir might be there, did not have the notes for this  
BT while doing the work, but it may be a white fir. There is a white fir  
tree with a blaze scar of appropriate size and direction to be the 11 ins.  
red fir BT. It is 3 ft. from the rock mound.

**Description of monument and accessories established to perpetuate the  
original location of this corner**

Set a 5/8" x30" rebar with a 2" aluminum cap in the center of the rock  
mound for the corner. John Mitchell had placed a bearing tree tag on the  
suspected BT.

REGISTERED  
PROFESSIONAL  
LAND SURVEYOR

*Leland Lee Myers*

OREGON  
JULY 8, 1965  
LELAND LEE MYERS  
699

Office of..... County of.....  
State of....., I hereby certify that the within instrument was filed in this office  
for record on the ..... day of .....; 19....., at..... o'clock .....m., (signed)  
..... by .....  
(COUNTY OFFICIAL) (DEPUTY)

FILED Aug. 31, 1977  
BAKER COUNTY SURVEYOR  
SURVEY NO. 9-37-17