


CERTIFIED RECORD OF LAND CORNER MONUMENTATION

History of original corner establishment:

Mineral Survey No. 480 completed August 2, 1902

Identical with the N.E. cor. of the location.
Set a white fir post 5 ins. square $4\frac{1}{2}$ ft. long 12 ins. in
the ground scribed BRC.C.4-480 with a mound of rocks around it.
A white fir tree 14 ins. in diam. bears N76°W, 49.1 ft.
" " " " 12 " " " " " N88°W, 49.7 ft.
both blazed and scribed BRC.C.4-480 BT.

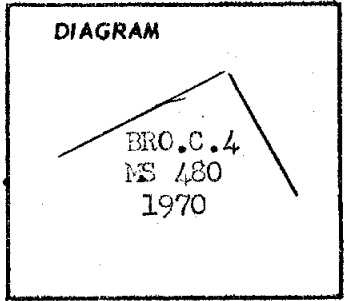

Description of corner evidence found:

Found the rock mound and two Douglas-fir bearing trees which have grown
to about 24". The 14" BT has been broken off and is now a stub about 6" high.

**Description of monument and accessories I established to perpetuate the
original location of this corner**

I set a 5/8" x 30" rebar with a 2" aluminum cap marked as shown above
in the center of the rock mound for the corner. John Mitchell had placed
bearing tree tags on the two BTs.

REGISTERED
PROFESSIONAL
LAND SURVEYOR
Leland Lee Myers
OREGON
JULY 3, 1965
LELAND LEE MYERS
699

Office of County of
State of , I hereby certify that the within instrument was filed in this office
for record on the day of , 19..... , at o'clockm., (signed)
..... by
(COUNTY OFFICIAL) (DEPUTY)

FILED Aug. 31, 1977

BAKER COUNTY SURVEYOR
SURVEY NO. 9-37-18