


CERTIFIED RECORD OF LAND CORNER MONUMENTATION

History of original corner establishment:

Not Available

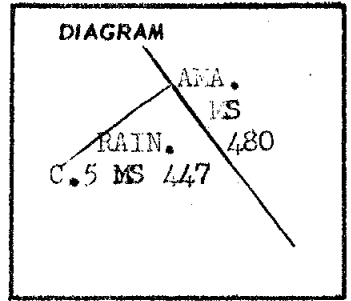

Description of corner evidence found:

Found a post with scribing and a bearing tree, a 16" Larch which bears S26°E, 11.1 ft. from the down post.

Description of monument and accessories established to perpetuate the original location of this corner

Set a 5/8" x 30" rebar with a 2" aluminum cap ~~with~~ marked as shown above at the point the post had entered the ground for the corner. John Mitchell had placed a bearing tree tag on the BT.

REGISTERED
PROFESSIONAL
LAND SURVEYOR

Leland Lee Myers

OREGON
JULY 9, 1966
LELAND LEE MYERS
609

Office of..... County of.....
State of....., I hereby certify that the within instrument was filed in this office
for record on the day of, 19....., at..... o'clockm., (signed)
..... by

(COUNTY OFFICIAL)

(DEPUTY)

FILED Aug. 31, 1977

BAKER COUNTY SURVEYOR

SURVEY NO. 9-37-19