

CERTIFIED RECORD OF LAND CORNER MONUMENTATION


History of original corner establishment:

Corner established by Herman L. Gradon under G.L.O. contract No. 416 dated August 19, 1881.

Surveyor General records state:

Set a post 3 1/2 ft long, 3 ins square, 24 ins in the ground, for 1/4 section corner marked 1/4 S on N face, from which:

A tamarack 12 ins diam bears N 10° W, 58 links dist marked 1/4 S BT
A pine 44 ins diam bears S 10° W, 43 links dist marked 1/4 S BT

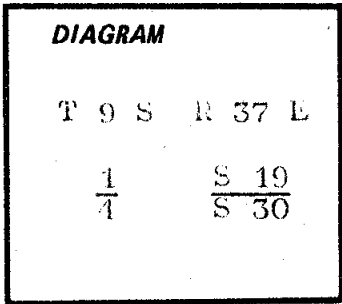

Description of corner evidence found:

None: Corner destroyed by dredging operations and relocated by single proportionate distance.

NOTE: SEE REVISED RECORD OF CORNER MONUMENTATION

SURVEY NO. 9-3732

Description of monument and accessories established to perpetuate the original location of this corner:

Set a 2 1/2 inch brass cap on a 2 inch iron pipe 31 ins long 26 ins in the ground with concrete encasement with a 6 ft steel fence post along side with signs 54-4 and 54-2 attached.

No bearing trees within limits on U.S. land. I therefore tied to Hwy 220 centerline as referenced by C.S.H.L. L/W monuments.

Hwy Sta PT 77+25.54 bears S 90° 46' 20" E, 253.20 ft
Hwy Sta PS 80+97.20 bears S 27° 22' 51" E, 621.86 ft

Brass cap marked thus: T 9 S R 37 E

$\frac{1}{4}$ $\frac{S 19}{S 30}$

1979

C.L.S. 1639

I hereby certify the above corner monument was re-established as herein described on May 25, 1979 witnessed by Brad Gordon, Tracy Labavee, Jim Lemastus

REGISTERED PROFESSIONAL LAND SURVEYOR

William L. Hanley

OREGON
JULY 14, 1978
WILLIAM L. HANLEY
1639

Office of...County Surveyor..... County of...Baker.....

State of...Oregon....., I hereby certify that the within instrument was filed in this office for record on the..... day of....., 19.....

..... by

(COUNTY OFFICIAL)

(DEPUTY)