


CERTIFIED RECORD OF LAND CORNER MONUMENTATION

History of original corner establishment:

Corner established by Herman B. Graton under G.L.C. contract No. 416 dated August 19, 1881.

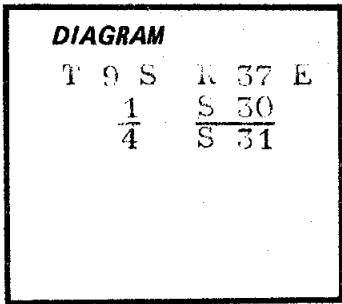

Surveyor General record states:

Set a post 3½ feet long, 3 inches square, 24 inches in the ground for ¼ section corner marked ¼ S on N face, from which:

- A tamarack 8 ins diam bears N 70° E. 21 links dist marked ¼ S BT
- A tamarack 5 ins diam bears S 20° E. 9 lks dist marked ¼ S BT

Description of corner evidence found:

A burned tamarack stump, sawed at 56 inches, with the letters BT still legible for section 30 BT  
No trace of section 31 BT (an old logging road has destroyed it) and no trace of original post.

Description of monument and accessories established to perpetuate the original location of this corner:

Set a 2½ inch brass cap on a 2 inch iron pipe 51 inches long, 26 inches in the ground with a 6 foot steel fence post alongside with a sign 54-4 attached.

New bearing trees:

- A fir 10 ins diam bears S 77° W, 40.0 ft dist marked ¼ S 31 BT
- A pine 8 ins diam bears N 02° E, 14.4 ft dist marked ¼ S 30 BT

Each BT has a sign 54-3 attached below a band of red paint and has a brass washer marked LS 1639 nailed flush with BT blaze.

Brass cap marked thus:  $\frac{1}{4}$  T 9 S R 37 E  $\frac{S 30}{S 31}$

G.L.S. 1659  
1979

I hereby certify the above corner monument was re-established as herein described on May 23, 1979, witnessed by Brad Gordon, head chainman

**REGISTERED  
PROFESSIONAL  
LAND SURVEYOR**

*William L. Hanley*

**OREGON  
JULY 14, 1978  
WILLIAM L. HANLEY  
1639**

Office of County Surveyor..... County of Baker  
 State of OREGON....., I hereby certify that the within instrument was filed in this office  
 for record on the..... day of....., 19.....  
 ..... by .....  
 (COUNTY OFFICIAL) (DEPUTY)