


CERTIFIED RECORD OF LAND CORNER MONUMENTATION

History of original corner establishment:

None: Corner established this survey.

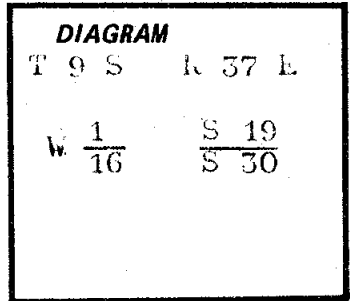

Description of corner evidence found:

None: Corner established this survey.

Description of monument and accessories established to perpetuate the original location of this corner:

Set a 2½ inch brass cap on a 2 inch iron pipe, 31 inches long, 26 inches in the ground marked as shown in the corner diagram with a 6 foot steel fence post alongside with signs 54-9 and 54-2 attached.

New bearing trees:

A fir 8 ins diam bears S 45° W, 16.7 ft marked W 1/16 S 30 BT
A pine 6 ins diam bears N 12° E, 18.8 ft marked W 1/16 S 19 BT
(Each BT has a sign 54-3 attached 6 inches below a band of red paint and has a brass washer marked LS 1639 nailed flush with BT blaze.)

Brass cap marked thus: T 9 S R 37 E

W $\frac{1}{16}$ S $\frac{19}{30}$

1979
O.L.S. 1639

I hereby certify the above corner monument was established as herein described on May 25, 1979, witnessed by Brad Gordon.

**REGISTERED
PROFESSIONAL
LAND SURVEYOR**

William L. Hanley

**OREGON
JULY 14, 1978
WILLIAM L. HANLEY
1639**

Office of County Surveyor County of Baker
Oregon
State of Oregon, I hereby certify that the within instrument was filed in this office
for record on the day of , 1979
by
(COUNTY OFFICIAL) (DEPUTY)