

Meridian based on OSHD.
Drawing no. BB-16-14. See
NOTES.

T.9S., R.36E., W.M. (NORTH, 80.0)
 N. 01°03'20" W., 2606.71' = 794.527 m
 N. 0°21'25" W., 2571.23' = 783.713 m
 T.9S., R.37E., W.M.

LEGEND

- FOUND BRASS CAP MONUMENT
- FOUND G.L.O. CORNER; SET 2 1/2" BRASS CAP ON 2" IRON PIPE
- SET 2 1/2" BRASS CAP ON 2" IRON PIPE AT PROPORTIONATE DISTANCE
- ⊙ SET 3/8" x 30" REBAR
- ⊙ FOUND OSHD R/W MONUMENT
- () G.L.O. RECORD BEARING AND DISTANCE
- PROPERTY BOUNDARY POSTED


SURVEYOR'S STATEMENT

I, WILLIAM L. HANLEY, A REGISTERED LAND SURVEYOR IN THE STATE OF OREGON, HEREBY CERTIFY THAT THIS PLAT AND THE NOTES HEREON OR ATTACHED, ARE A CORRECT REPRESENTATION OF A SURVEY PERFORMED BY ME DURING MAY, 1979 FOR THE U.S. FOREST SERVICE, IN ACCORDANCE WITH THE STATUTES OF THE STATE OF OREGON AND WITH THE ARTICLES OF MY CONTRACT.

William L. Hanley
ORLS 1639

SOLAR OBSERVATION DATA

TRANSIT STA. NO 42
 N. 23°40'35" W., 69.85 FT. FROM
 NORTH 1/4 COR. SECTION 30.
 JULY 6, 1979
 LATITUDE 44°45'35"
 DECLINATION 22°42'15"
 VERTICAL ANGLE 39°06'55"
 MEAN DECLINATION 19°30'E

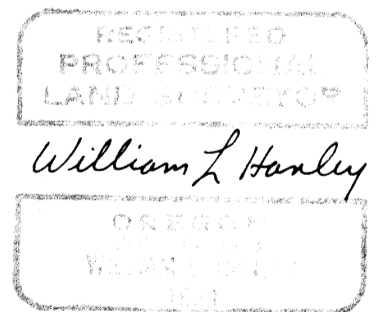

U.S. GOVERNMENT LAND LOCATED IN
SECTION 30, T.9S., R.37E., W.M.

ALL OF THE SW 1/4
THE NW 1/4 AND THE SE 1/4 (EXCEPTING THAT PART CONTAINED
BY THE MARY AGNES CONSOLIDATED PLACER, MS 198, AND
THAT PART OF THE OSHD RIGHT OF WAY)

NOTES

FOR MONUMENTATION RECORDS SEE CERTIFIED
RECORD OF CORNER MONUMENTATION SHEETS
FILED SEPARATELY.

THE SOLAR OBSERVATION IS FOR AZIMUTH
CHECK ONLY - THE BASIS OF BEARING IS FROM
OSHD DRAWING NO. BB-16-14 WHICH SHOWS
THE BEARING BETWEEN STA 531+01.85 PI
AND 569+91.65 PS BEARS N. 54°32'30" W

RECORD OF SURVEY PLAT
SUMPTER-GRANITE CADASTRAL SURVEY

U.S. FOREST SERVICE CONTRACT NO. 53-04HI-8-7079N

Surveyed May 3-23, 1979

Scale 1" = 400'

SURVEYED BY HANLEY ENGINEERING

July 11, 1979

9-37-26