


Exhibit VIII - South Sumpter Ellis' Addition

Reduced Blueprint of Original Plat from Deeds Book 31-182

See Notes 2, 3, 4, 5, 6 and 21

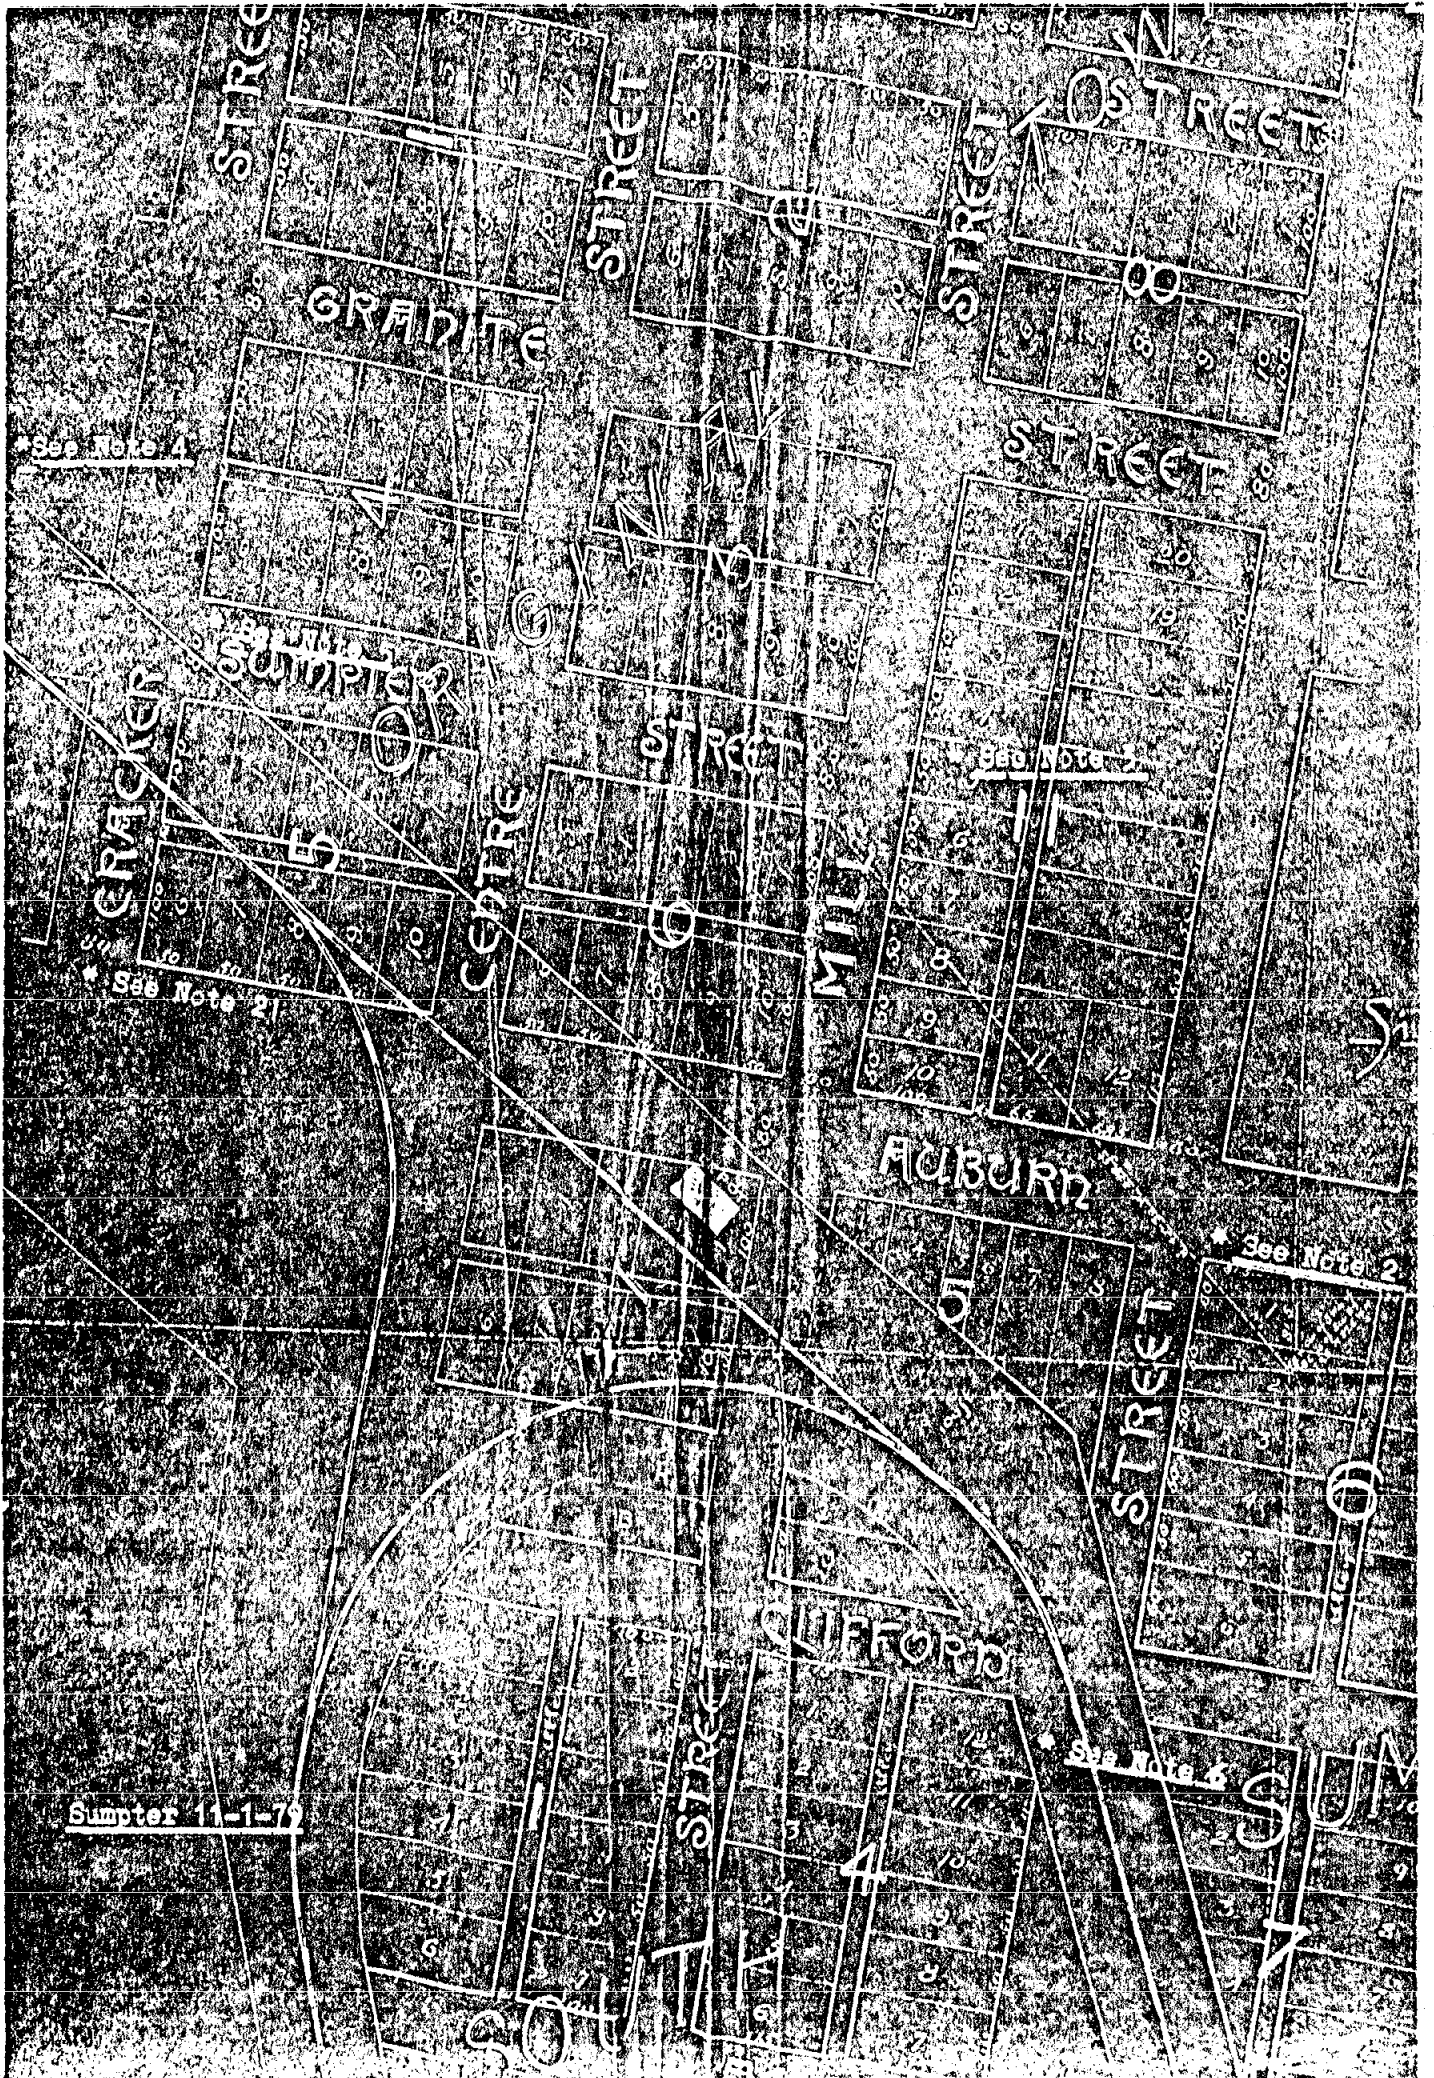

Sumpter 11-1-79