Exhibit XIV - Sunnyside-Parkinson's Addition
Reduced Original Tracing from Plat Book 1, Page 45

See Notes 10, 11 & 14

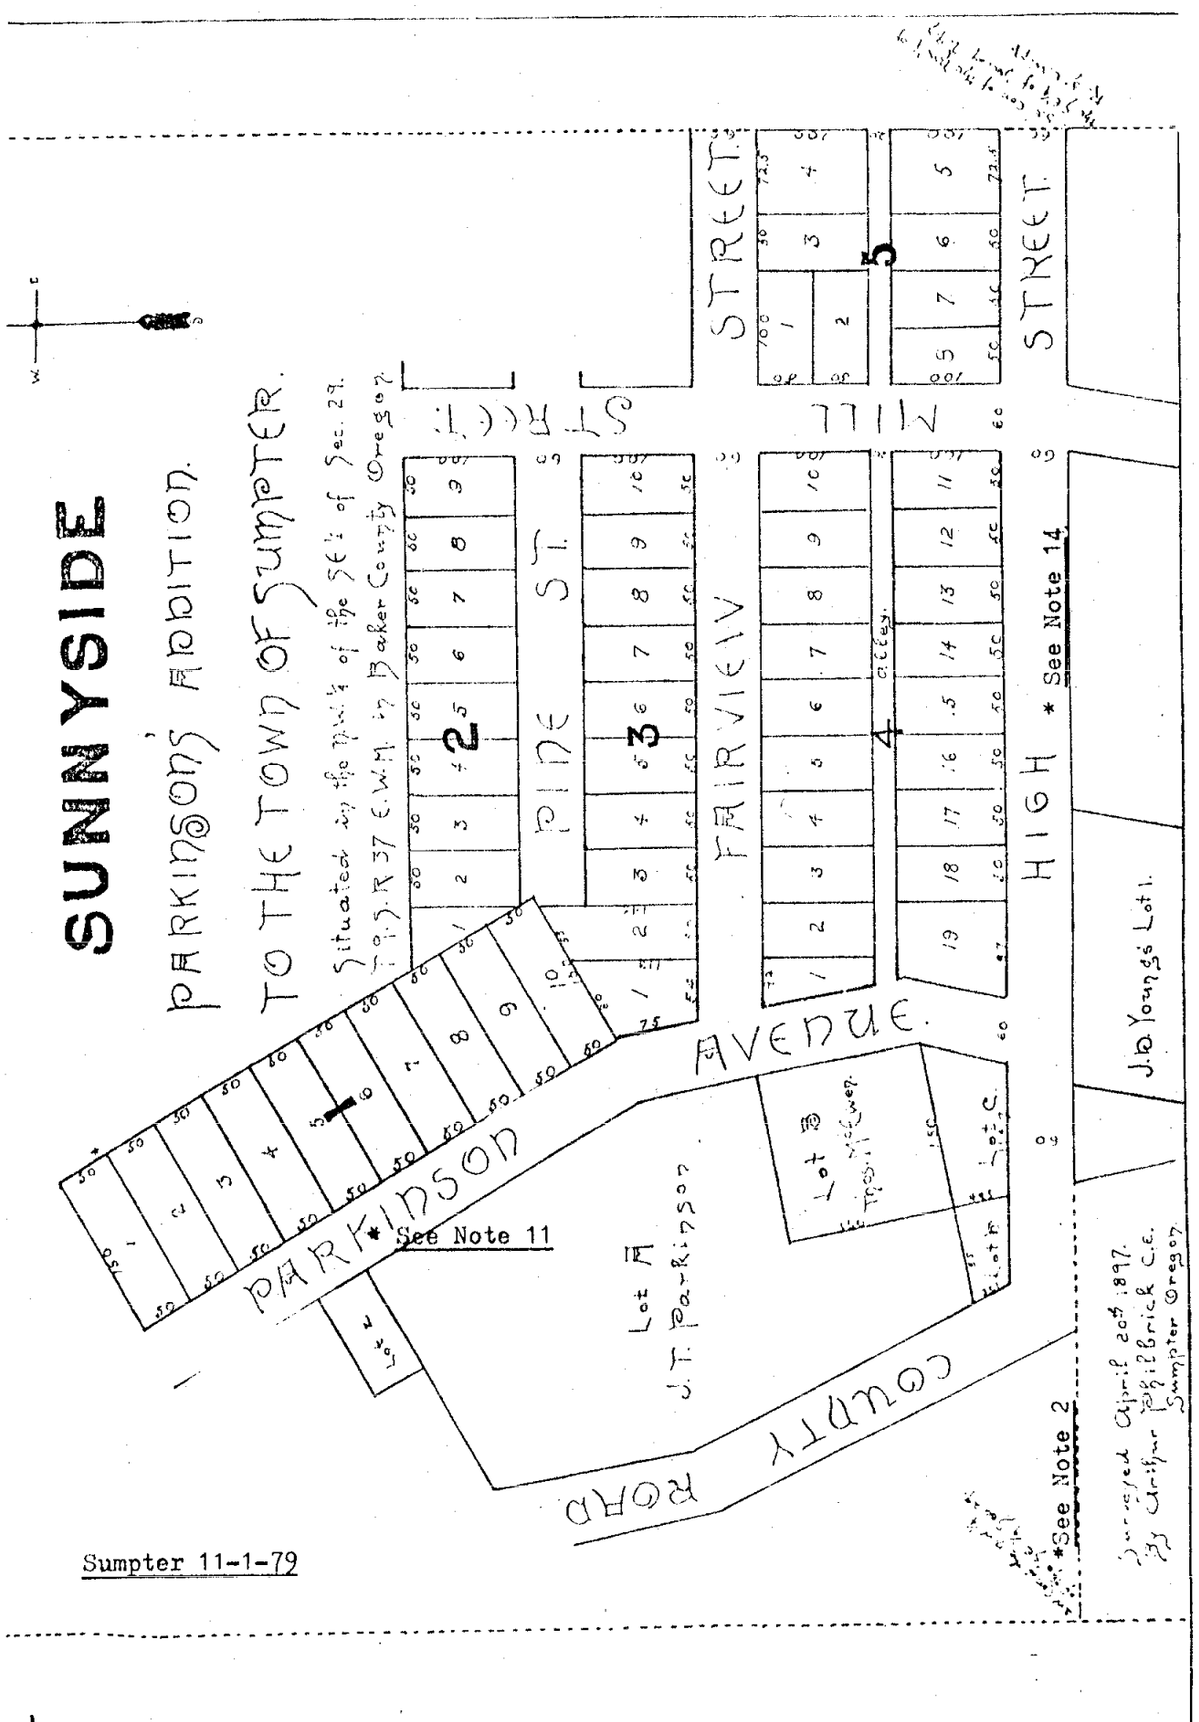

Sumpter 11-1-79