Exhibit XVII - STS First Addition
Reduced Original Tracing from Plat Book 3, Page 32
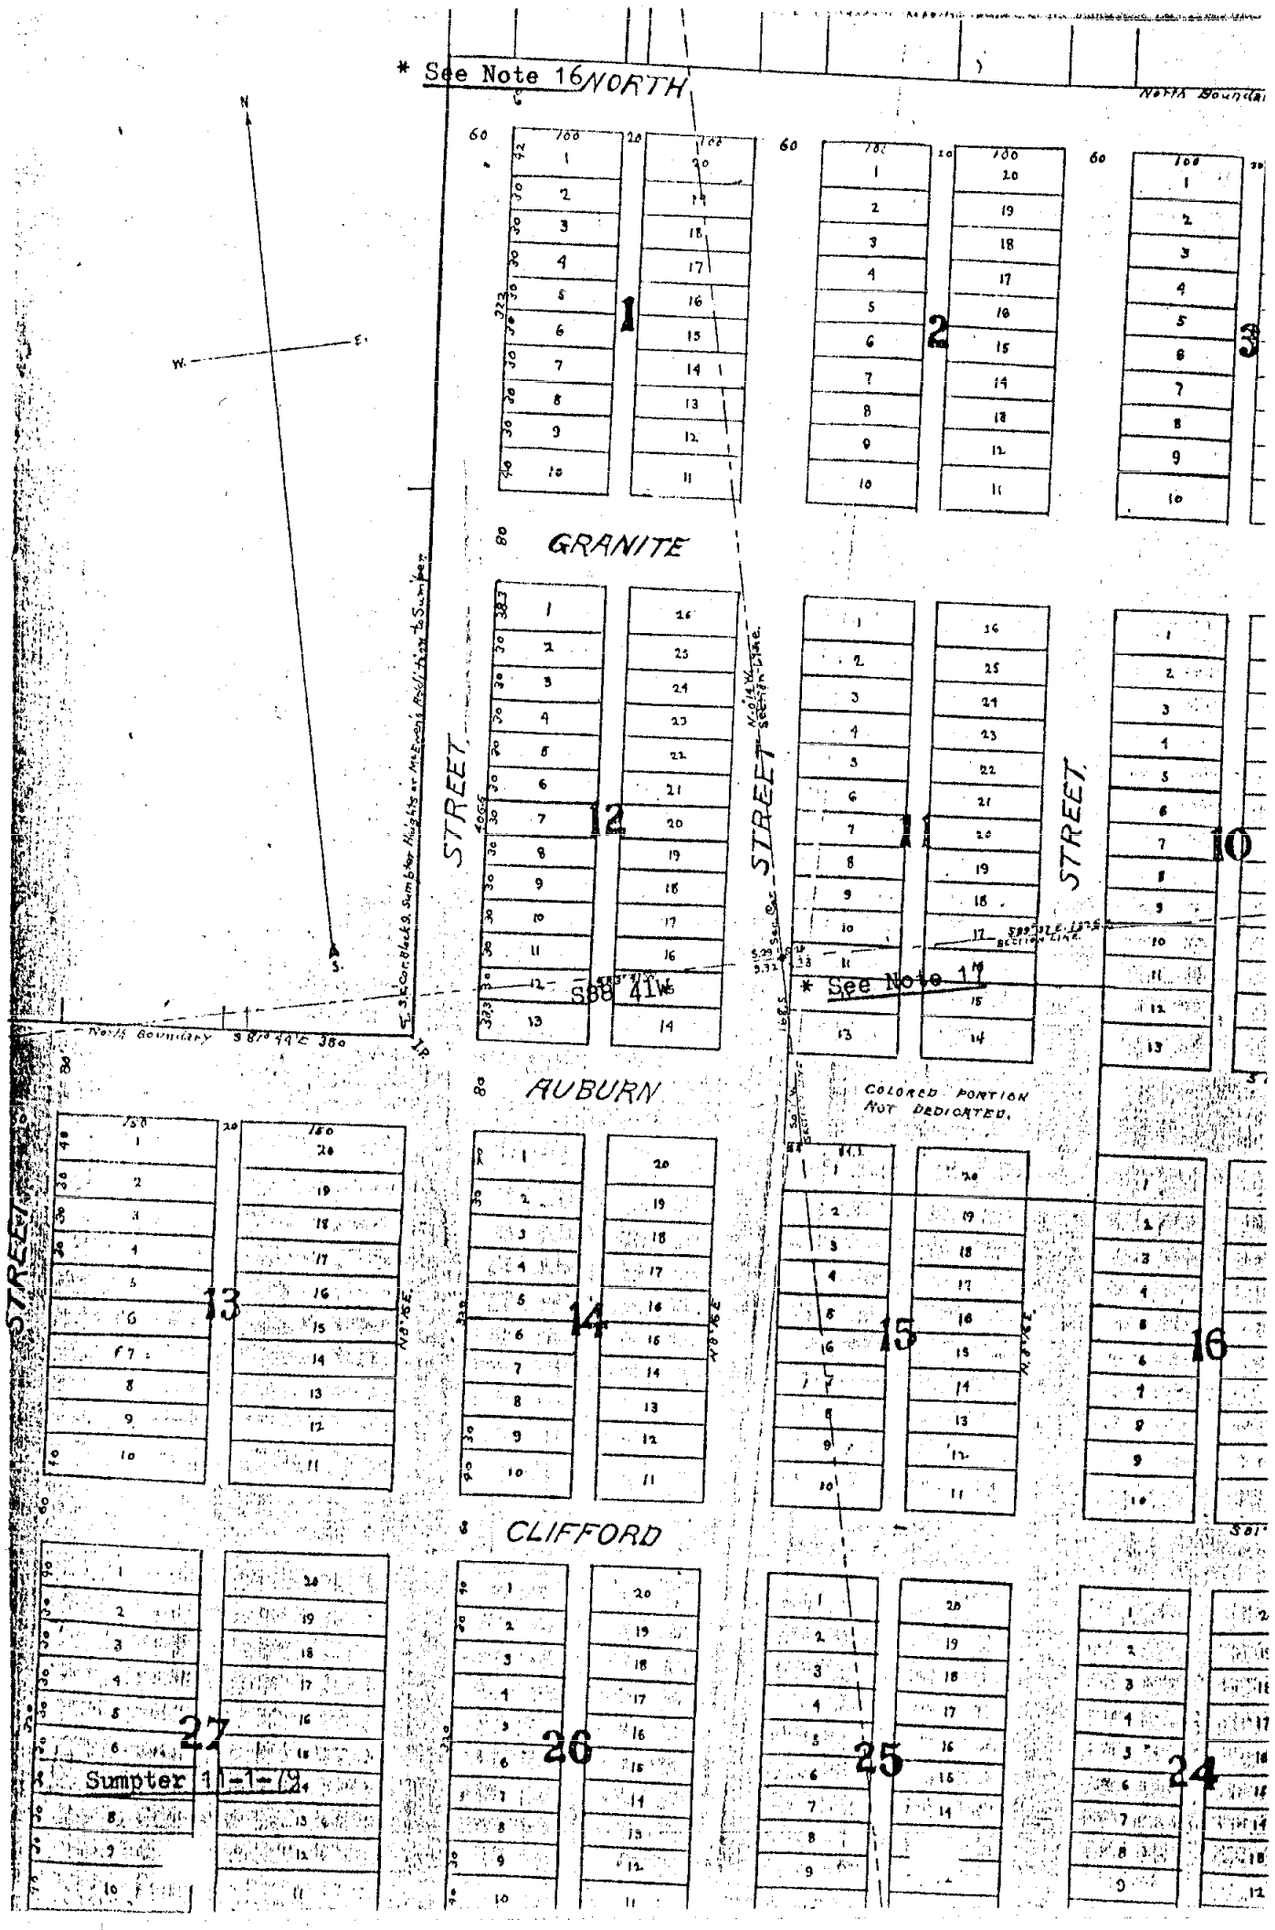
See Notes 16 and 17