

- ### LEGEND
- FOUND CORNER OF RECORD (BRASS CAP).
 - FOUND ORIGINAL CORNER EVIDENCE AND SET MONUMENT AS DESCRIBED ON ATTACHED U.S.F.S. FORM RG-7100-57.
 - ⊙ SET MONUMENT AS DESCRIBED ON ATTACHED U.S.F.S. FORM RG-7100-57.
 - () RECORD DATA FROM ORIGINAL SURVEY
 - * () RECORD DATA FROM 1979 SURVEY.
 - [] METERS
 - POSTED BOUNDARY LINES
 - ⊙ SECTION NUMBERS.

BASIS OF BEARING

SOLAR OBSERVATION
11-20-79

MEAN MAGNETIC DECLINATION

N 20° 00' E

NOTES

- ⊙ 1/4 CORNER OF SECTIONS 19 AND 30 ESTABLISHED WITH REFERENCE MONUMENTS PLAT DISTANCES ARE COMPUTED TO TRUE POSITION.
- ⊙ THE W 1/16 CORNER OF SECTIONS 19 & 30 SURVEYED POSITION IS 59° 09' 44" W, 0.31 FT. FROM COMPUTED POSITION

NEW BEARING TREES

- N-5 5" PINE, BEARS N 27° E, 86.0 FT., SCRIBED S11 BT.
5" PINE, BEARS S 86° E, 78.0 FT., SCRIBED S 20 BT.
5" PINE, BEARS S 15° W, 107.6 FT., SCRIBED S 19 BT.
- R-1 10" LODGEPOLE PINE, BEARS N 69° E, 43.7 FT., SCRIBED T9S R37E S19 BT.
- R-3 18" PINE, BEARS N 47 1/2° E, 254.5 FT., SCRIBED 1/4 S19 BT.
- R-5 9" PINE, BEARS S 03° W, 50.6 FT., SCRIBED T9S R37E S30 BT.
6" FIR, BEARS N 10° W, 19.3 FT., SCRIBED T9S R37E S19 BT.

REFERENCE MATERIAL

ORIGINAL G.L.O. PLAT AND NOTES.
FIELD BOOKS 4, 7 AND 8.
SURVEY #9-37-26.

SURVEY HISTORY

SECTIONS 19 AND 20, T9S, R37E, W.M.
THE WEST SECTION LINE OF SECTION 19, T9S, R37E, W.M., WAS ESTABLISHED BY E. MCCORMACK UNDER G.L.O. CONTRACT NO. 398, DURING SEPTEMBER 28, 1881.
THE INTERIOR CORNERS FOR SECTIONS 19 AND 20, T9S, R37E, W.M., WAS ESTABLISHED BY HERMAN D. GRADON, UNDER G.L.O. CONTRACT NO. 416, DURING NOVEMBER, 1881.
THE SOUTH LINE OF SECTION 19, T9S, R37E, W.M., WAS RE-SURVEYED BY HANLEY ENGINEERING IN 1979, SETTING THE 1/4 CORNER FOR SECTIONS 19 AND 30, T9S, R37E, W.M., AND THE W 1/16 CORNER FOR SECTIONS 19 AND 30, T9S, R37E, W.M.

NOTE FORM RG-7100-57 FILED AT BAKER COUNTY SURVEYOR'S FOR STANDARD INDEX FILE NUMBER N-1, N-3, N-7, N-8, P-2, P-3, P-7, P-8, Q-3, Q-5, Q-7 & Q-8.
REVISED 1-2-80



CONTRACT NO. 53-04HI-9-7614N

I, BARRY B. BARBOUR, a registered land surveyor in the State of Oregon, hereby certify that this plat and the notes hereon, or attached, are a correct representation of a survey I performed during November, 1980 - April, 1980 for the U.S. Forest Service, in accordance with the Statutes of the State of Oregon and with the Articles of the Contract.

Barry B. Barbour

Barry B. Barbour
Professional Land Surveyor
Oregon License 1051

DATE June 27, 1980
SERIAL NO 9-37-33

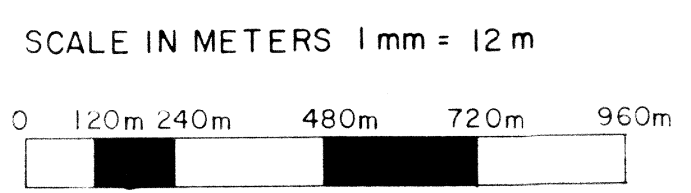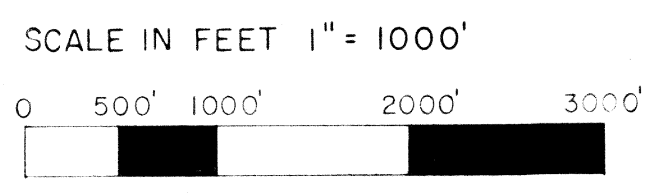

SECTIONS 19 & 20, T9S, R37E, W.M.		
BAKER COUNTY,		OREGON
U.S.F.S. - WALLOWA-WHITMAN NATIONAL FOREST		
SCALE 1" = 1000' 1mm = 12m	BARRY B. BARBOUR	SHEET NO.
DATE JUNE, 1980	PROFESSIONAL LAND SURVEYOR	