


CERTIFIED RECORD OF LAND CORNER MONUMENTATION

Index File No. N-3

History of original corner establishment:

Corner was originally established by Herman D Gradon under G. L. O. contract No. 416, durnig November 1881. Surveyors General's notes state: " Set a post 3 1/2 ft. long, 3" square 24" in the ground for 1/4 section corner marked 1/4S on North face. From which: A tamarack 12" in diameter bears N10°W, 58 lks. dist. marked 1/4S BT. A pine 44" in diameter bears S10°W, 43 lks. dist. marked 1/4S BT. "

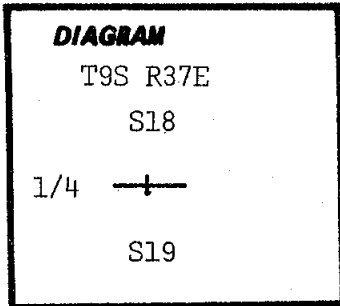

Description of corner evidence found:

No definite trace of BTs could be found. One old Pine stump was checked but no sign of Tamarac BT could be found. Surveyed position is about 10' North of area skimmed for post.

Corner falls about 100' West of road on ridge.

Description of monument and accessories | established to perpetuate the original location of this corner:

At surveyed point set 2 1/2" X 30" galvanized pipe and brass cap marked: Set pipe 25" in the ground. No rock in the area. From which by magnetic declination of N20°E: A 10" Fir bears N06°E, 68.1 ft. scribed 1/4S18 BT. AN 11" Tamarac bears S 21°W, 13.1 ft. scribed 1/4S19 BT. Painted blazes red and 6" red band around. Placed 54-3s and brass washers stamped PLS 1051 on BTs. Placed 54-4 on steel fence post 5' West of the corner.

T9S R37E
S18
1/4
S19
OR PLS 1051
1980

I hereby certify that the above corner monument was reestablished as herein described.

Witnesses: Daniel T. Rowland
Robert Boling

May 23, 1980

REGISTERED PROFESSIONAL LAND SURVEYOR

Barry B. Barbour

OREGON
OCT. 17, 1975
BARRY B. BARBOUR
1051

Office of... County Surveyor... County of... Baker
State of... Oregon... I hereby certify that the within instrument was filed in this office for record on the... 27... day of... June... 1980
James D. Hanley... by... Tom Hanley
(COUNTY OFFICIAL) (DEPUTY)