


CERTIFIED RECORD OF LAND CORNER MONUMENTATION

Index File No. N-7

History of original corner establishment:

Corner was originally established by Herman D. Gradon under G. L. O. contract No. 416, during October 27, to November 1, 1881. Surveyors General's notes state: "Set a sandstone 16 X 12 X 4 ins. 11ins. in the ground for 1/4 sec. cor. marked 1/4 on N. face; from which A Pine 24 ins. diam. bears N20°E, 46 lks. dist. marked 1/4S BT. A Pine 20" ins. diam. bears S60°E, 22 lks. dist. marked 1/4S BT.

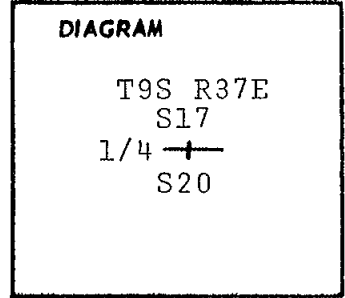

Description of corner evidence found:

Found 15" X 12" X 3" stone set in small mound of stone and 5/8" rebar. Stone clearly marked 1/4 on North face. No definite trace of BTs found. Possible stump holes at approximate BT locations. Area has been badly burnt.


Field book #4, page 17.

Corner falls about 65' East of a North-South ridge.

Description of monument and accessories established to perpetuate the original location of this corner

At the center of the above described stone, set 2 1/2" X 30" galvanized pipe and brass cap marked: Set pipe 20" in the ground to bedrock and mound of stone around to cap. Placed marked stone at base of pipe. Threw a 5/8" X 30" piece of rebar away. From which by magnetic declination of N20°E: A 12" Pine bears N44°E, 114.4 ft. scribed 1/4 S17 BT. A 16" Pine bears S83°E, 73.1 ft. scribed 1/4S20 BT. Placed 54-3s and brass washers stamped PLS 1051 on the BTs. Painted blazes red and 6" red band around. Placed 54-2 and 54-4 on a steel fence post 5' South and 54-2 on a steel fence post 5' East of the corner.

T9SR37E
S17
1/4 —+—
S20
OR PLS 1051
1979

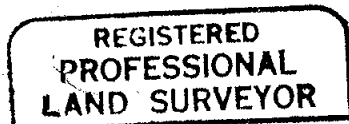

Barry B. Barbour
OREGON
OCT. 17, 1975
BARRY B. BARBOUR
1051

I hereby certify that the above corner monument was reestablished as herein described.

Witnesses: Daniel T. Rowland
Ronald Gilroy

November 21, 1979

Office of County Surveyor..... County of Baker.....
State of Oregon....., I hereby certify that the within instrument was filed in this office for record on the 27 day of June 1980.
James D. Hanley by *Tom Hanley*
(COUNTY OFFICIAL) (DEPUTY)

June 27, 1980