


**CERTIFIED RECORD OF LAND CORNER MONUMENTATION**

Index File No. N-8

**History of original corner establishment:**

None.

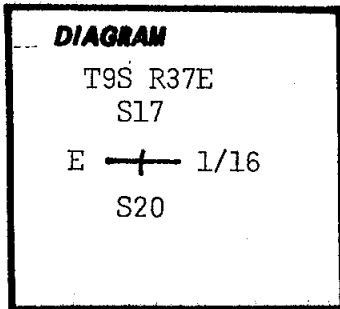

**Description of corner evidence found:**

Not Set.

Corner is about 50' West of Cracker Creek road.

**Description of monument and accessories established to perpetuate the original location of this corner:**

At surveyed point set 2 1/2" X 30" galvanized pipe and brass cap marked: Set pipe 24" in the ground and mound of stone around to cap.

From which by magnetic declination of N20°E:

A 9" pine bears S22°W, 12.8 ft. scribed E1/16S20 BT. An 8" pine bears N46°W, 11.1 ft. scribed E1/16S17 BT. Painted blazes red and 6" red band around. Placed 54-3s and brass washers stamped PLS 1051 on BTS. Placed 54-2 and 54-4 on steel fence post 5' South and 54-2 and 54-9 on steel fence post 5' West of the corner.

T9S R37E  
S17  
E —+— 1/16  
S20  
OR PLS 1051  
1980

I hereby certify that the above corner monument was reestablished as herein described.

Witnesses: Daniel T. Rowland  
Harry Dunn

May 9, 1980

**REGISTERED  
PROFESSIONAL  
LAND SURVEYOR**

*Barry B. Barbour*  
OREGON  
OCT. 17, 1975  
BARRY B. BARBOUR  
1051

Office of.....County Surveyor..... County of.....Baker.....  
State of.....Oregon....., I hereby certify that the within instrument was filed in this office  
for record on the...27... day of...June....., 19...80  
.....James D. Hanley..... by .....Tom Hanley.....  
(COUNTY OFFICIAL) (DEPUTY)

Form R6-7100-57 (9/71)

June 27, 1980

FILED June 27, 1980  
BAKER COUNTY SURVEYOR  
SURVEY NO. 9-37-3537